




Scale: 1"=400'  
Date: September 7, 2021

LEGEND

- Found Survey Monument
- Denotes Building
- · - · - Denotes Buried Pipeline Location Approximate
- ▣ Denotes Area Irrigated
- (M) Denotes Flow Meter
- (F) Denotes Fish Screen

Note: Fish Screen and Flow Meter At Point of Diversion

This map was prepared for the purpose of identifying the location of a water right only and is not intended to provide legal dimensions or location of property ownership.

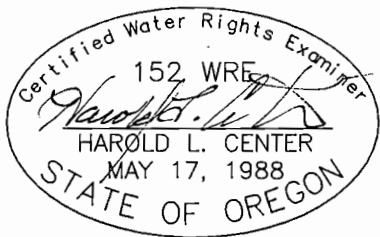


Renews: 12-31-21

HAROLD L. CENTER  
2604 David Lane  
Medford, OR. 97504  
Phone 541-535-6108  
Oregon Certificate No. 152  
Project: Self\_Thompson\_21-16

CLAIM OF BENEFICIAL USE MAP – TRANSFER–T 12477  
SW1/4NE1/4, SECTION 7, TAX LOT 400 MAP 39 4W 07  
TOWNSHIP 39 SOUTH, RANGE 4 WEST, W.M.  
JACKSON COUNTY, OREGON

FOR  
STEVEN M. SELF  
226 N. PAGE ST.  
PORTLAND, OR 97227

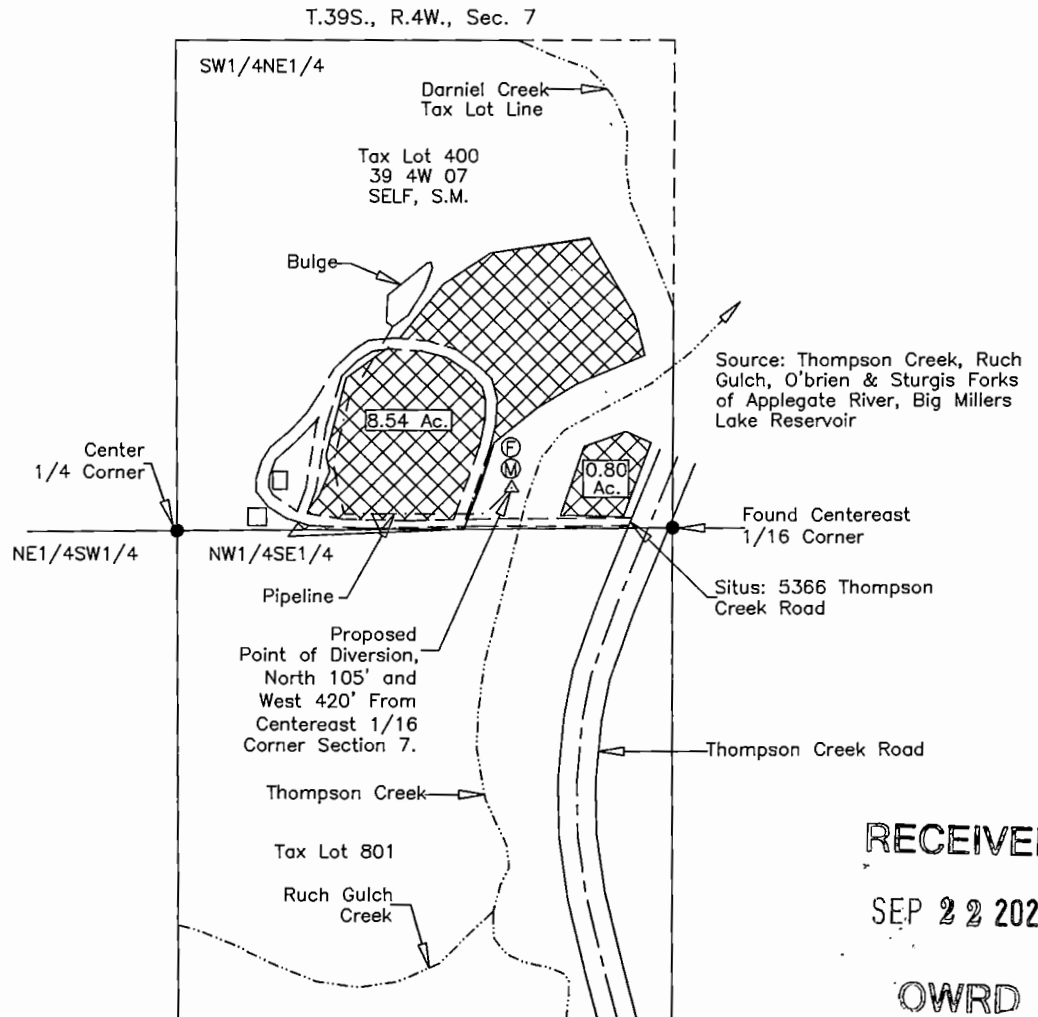

RECEIVED

SEP 22 2021

OWRD