


IN THE SW.1/4 OF SE.1/4, SECTION 5, TOWNSHIP 2 N., RANGE 12 E. W.M.
 WASCO COUNTY, OREGON

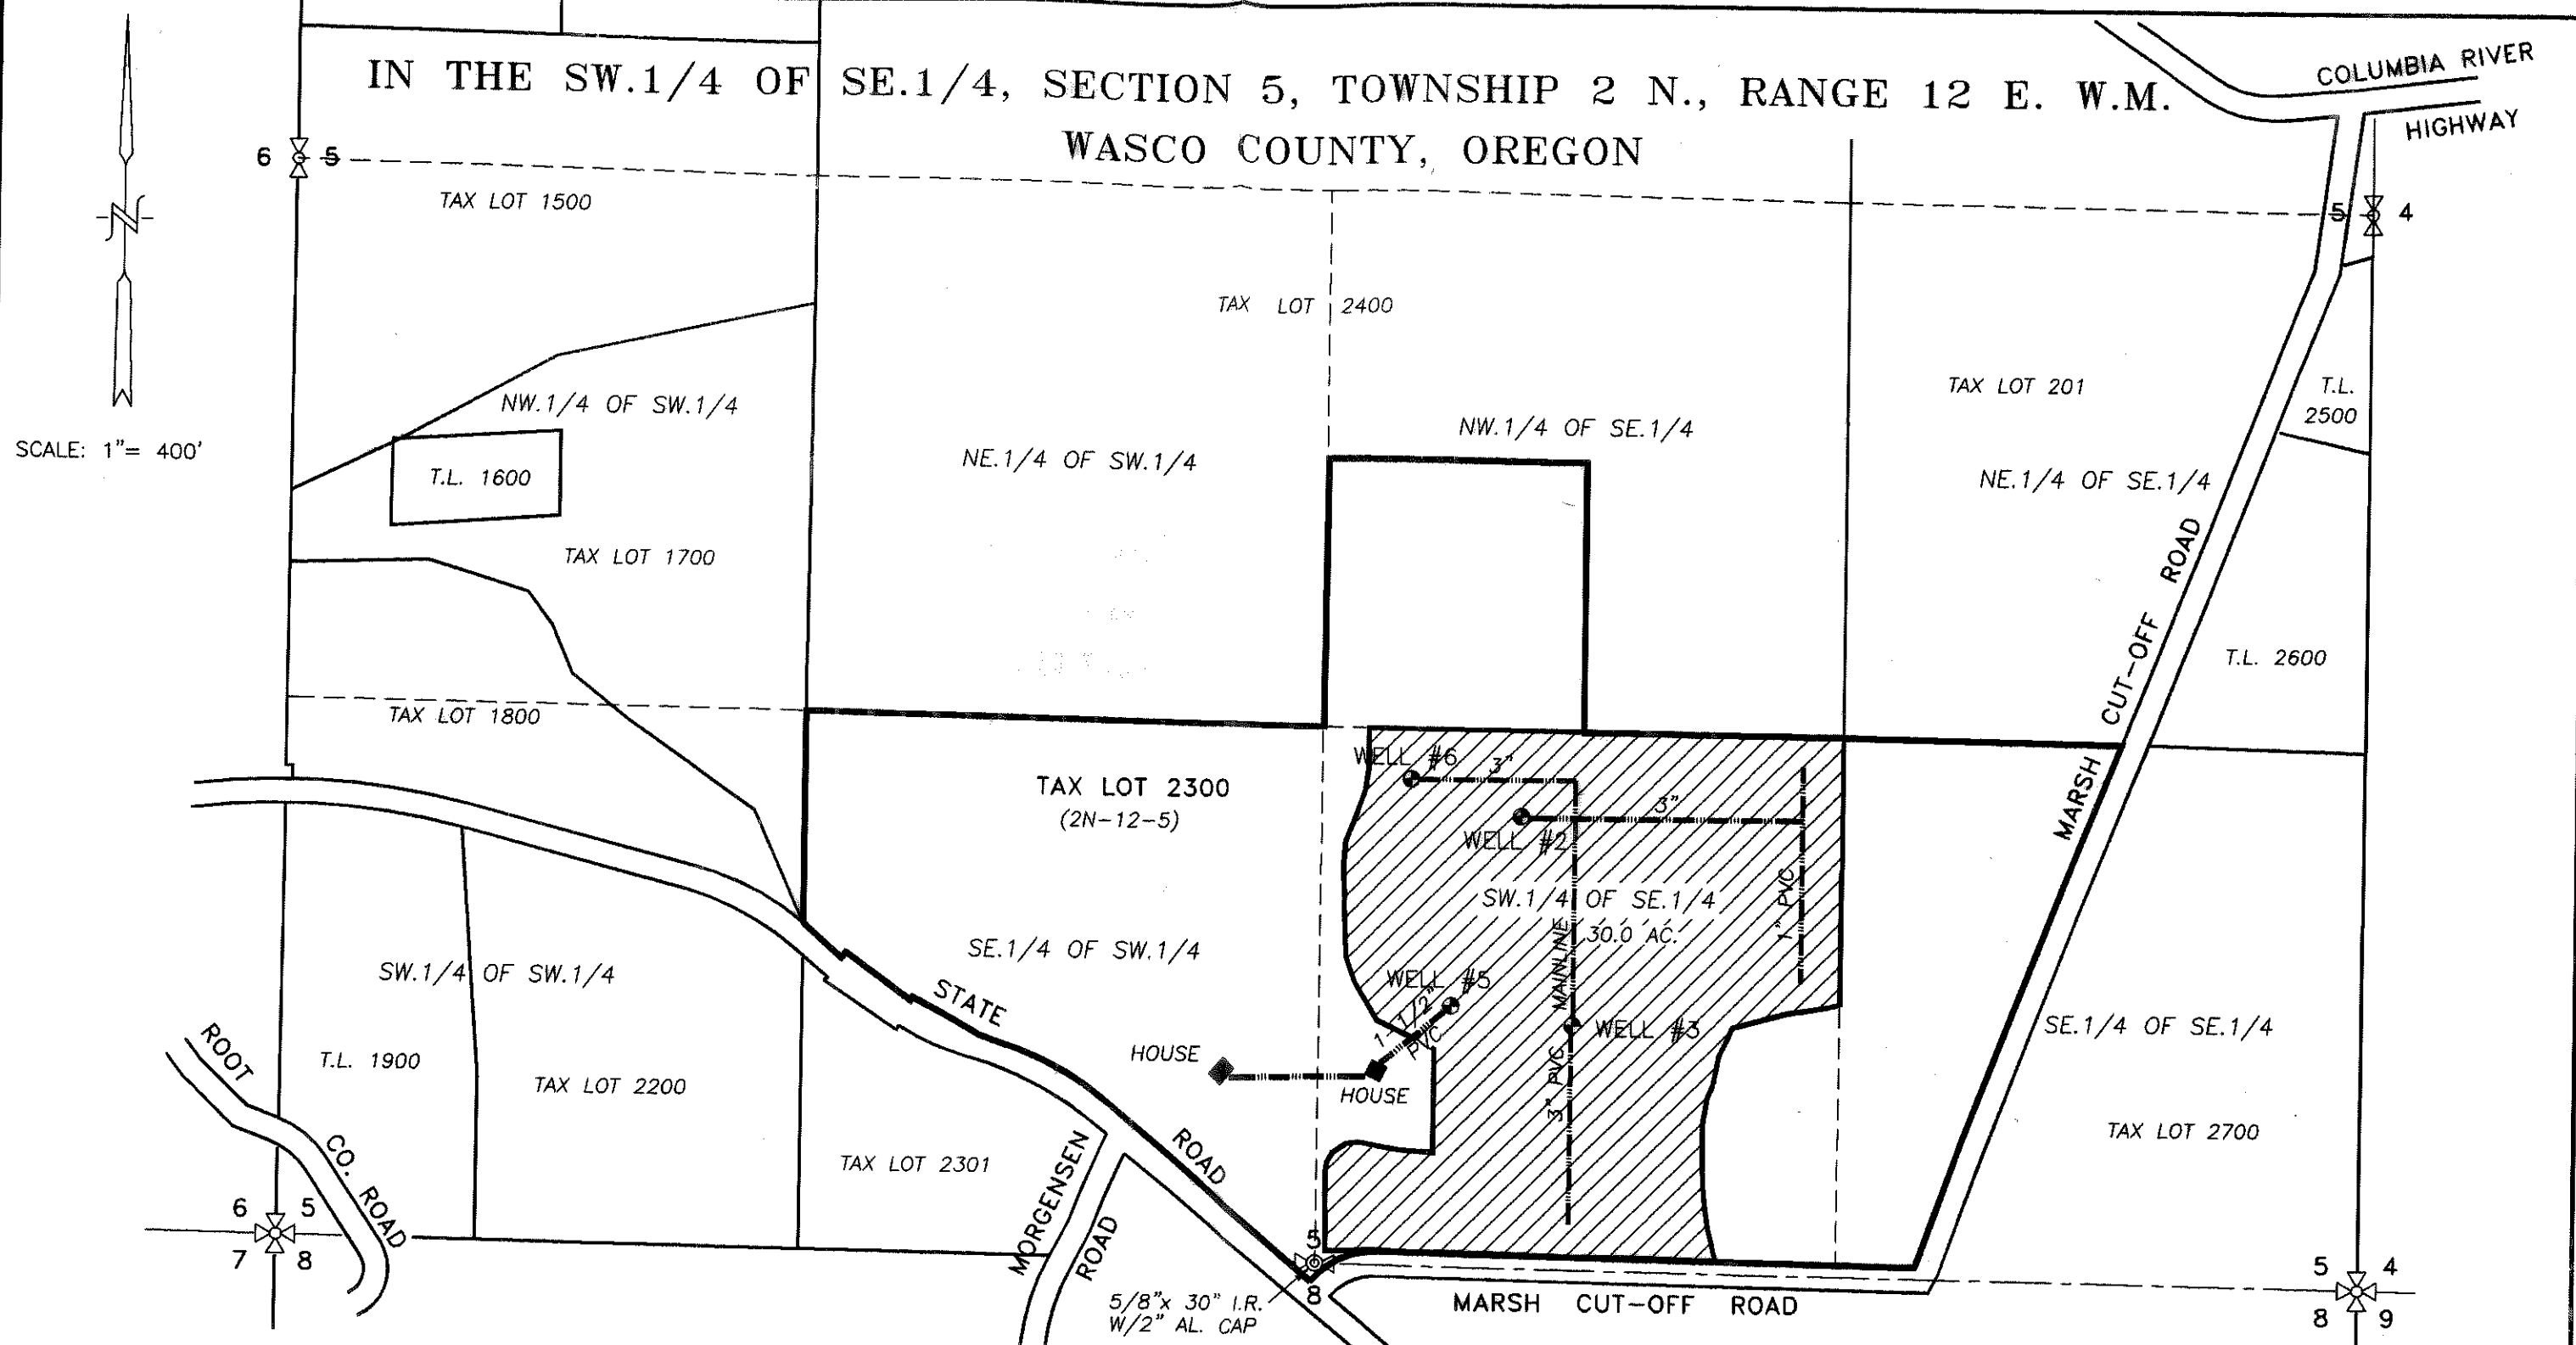

APPLICATION No. G-14282
 PERMIT No. G-13170
 IN THE NAME OF:
JAY STEVENS & TODD O. STEVENS
 DATE: SEPTEMBER 25, 2002


WATER RIGHT FINAL PROOF SURVEY
 SCALE: 1" = 400'

BY: TENNESON ENGINEERING CORP.
 409 LINCOLN STREET,
 THE DALLES, OREGON. 97058
 PH. 541-296-9177
 FAX 541-296-6657

WELL LOCATIONS:
 WELL #2 - 1100' N. & 490' E.
 WELL #3 - 590' N. & 625' E.
 WELL #5 - 635' N. & 325' E.
 WELL #6 - 1190' N. & 220' E.

ALL FROM THE
 S.1/4, SEC. 5

NOTE:
 "THIS MAP IDENTIFIES THE LOCATION OF
 THE WATER RIGHT ONLY AND IS NOT
 INTENDED TO PROVIDE DIMENSIONS OR
 LOCATE PROPERTY OWNERSHIP LINES."

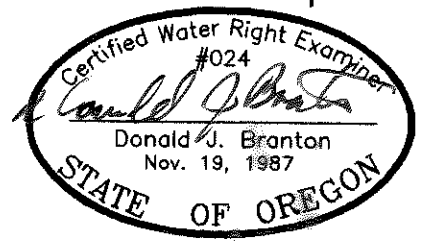

RENEW: 12/31/03 W.O. #1055wr