



T.17S., R.20E., W.M.

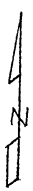

Surveyed March 10, 2018
 C-81673 (Shotgun Cr.)
 Scale 1"=1320'
 (4"=1 mile)
 ● To: 10[±] acres 1889
 ● Remaining Right 10[±] acres 1889

Shotgun
POD 1 &
fish screen

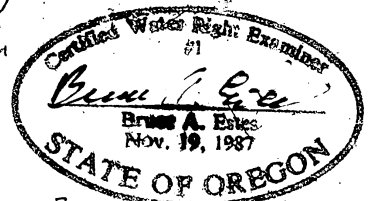



Claim of Beneficial Use Map T-11750
 for
 Shotgun Ranch, LLC

This map is for the purpose of
 locating a water right only
 and has no intent to provide
 legal dimensions or the location
 of property lines.






Sheet 1 of 2
 Renewal Dec 31, 2019
ESTES SURVEYS, LLC
 PO Box 17518
 Salem, OR 97306-7519
 (503) 565-7503
 60352 Arnold Rd
 Bend, OR 97702
 (541) 382-7391

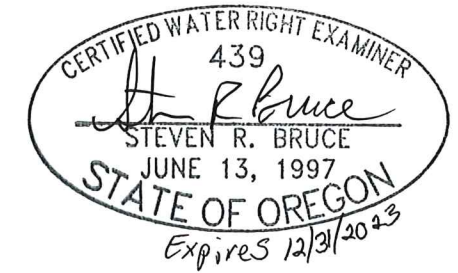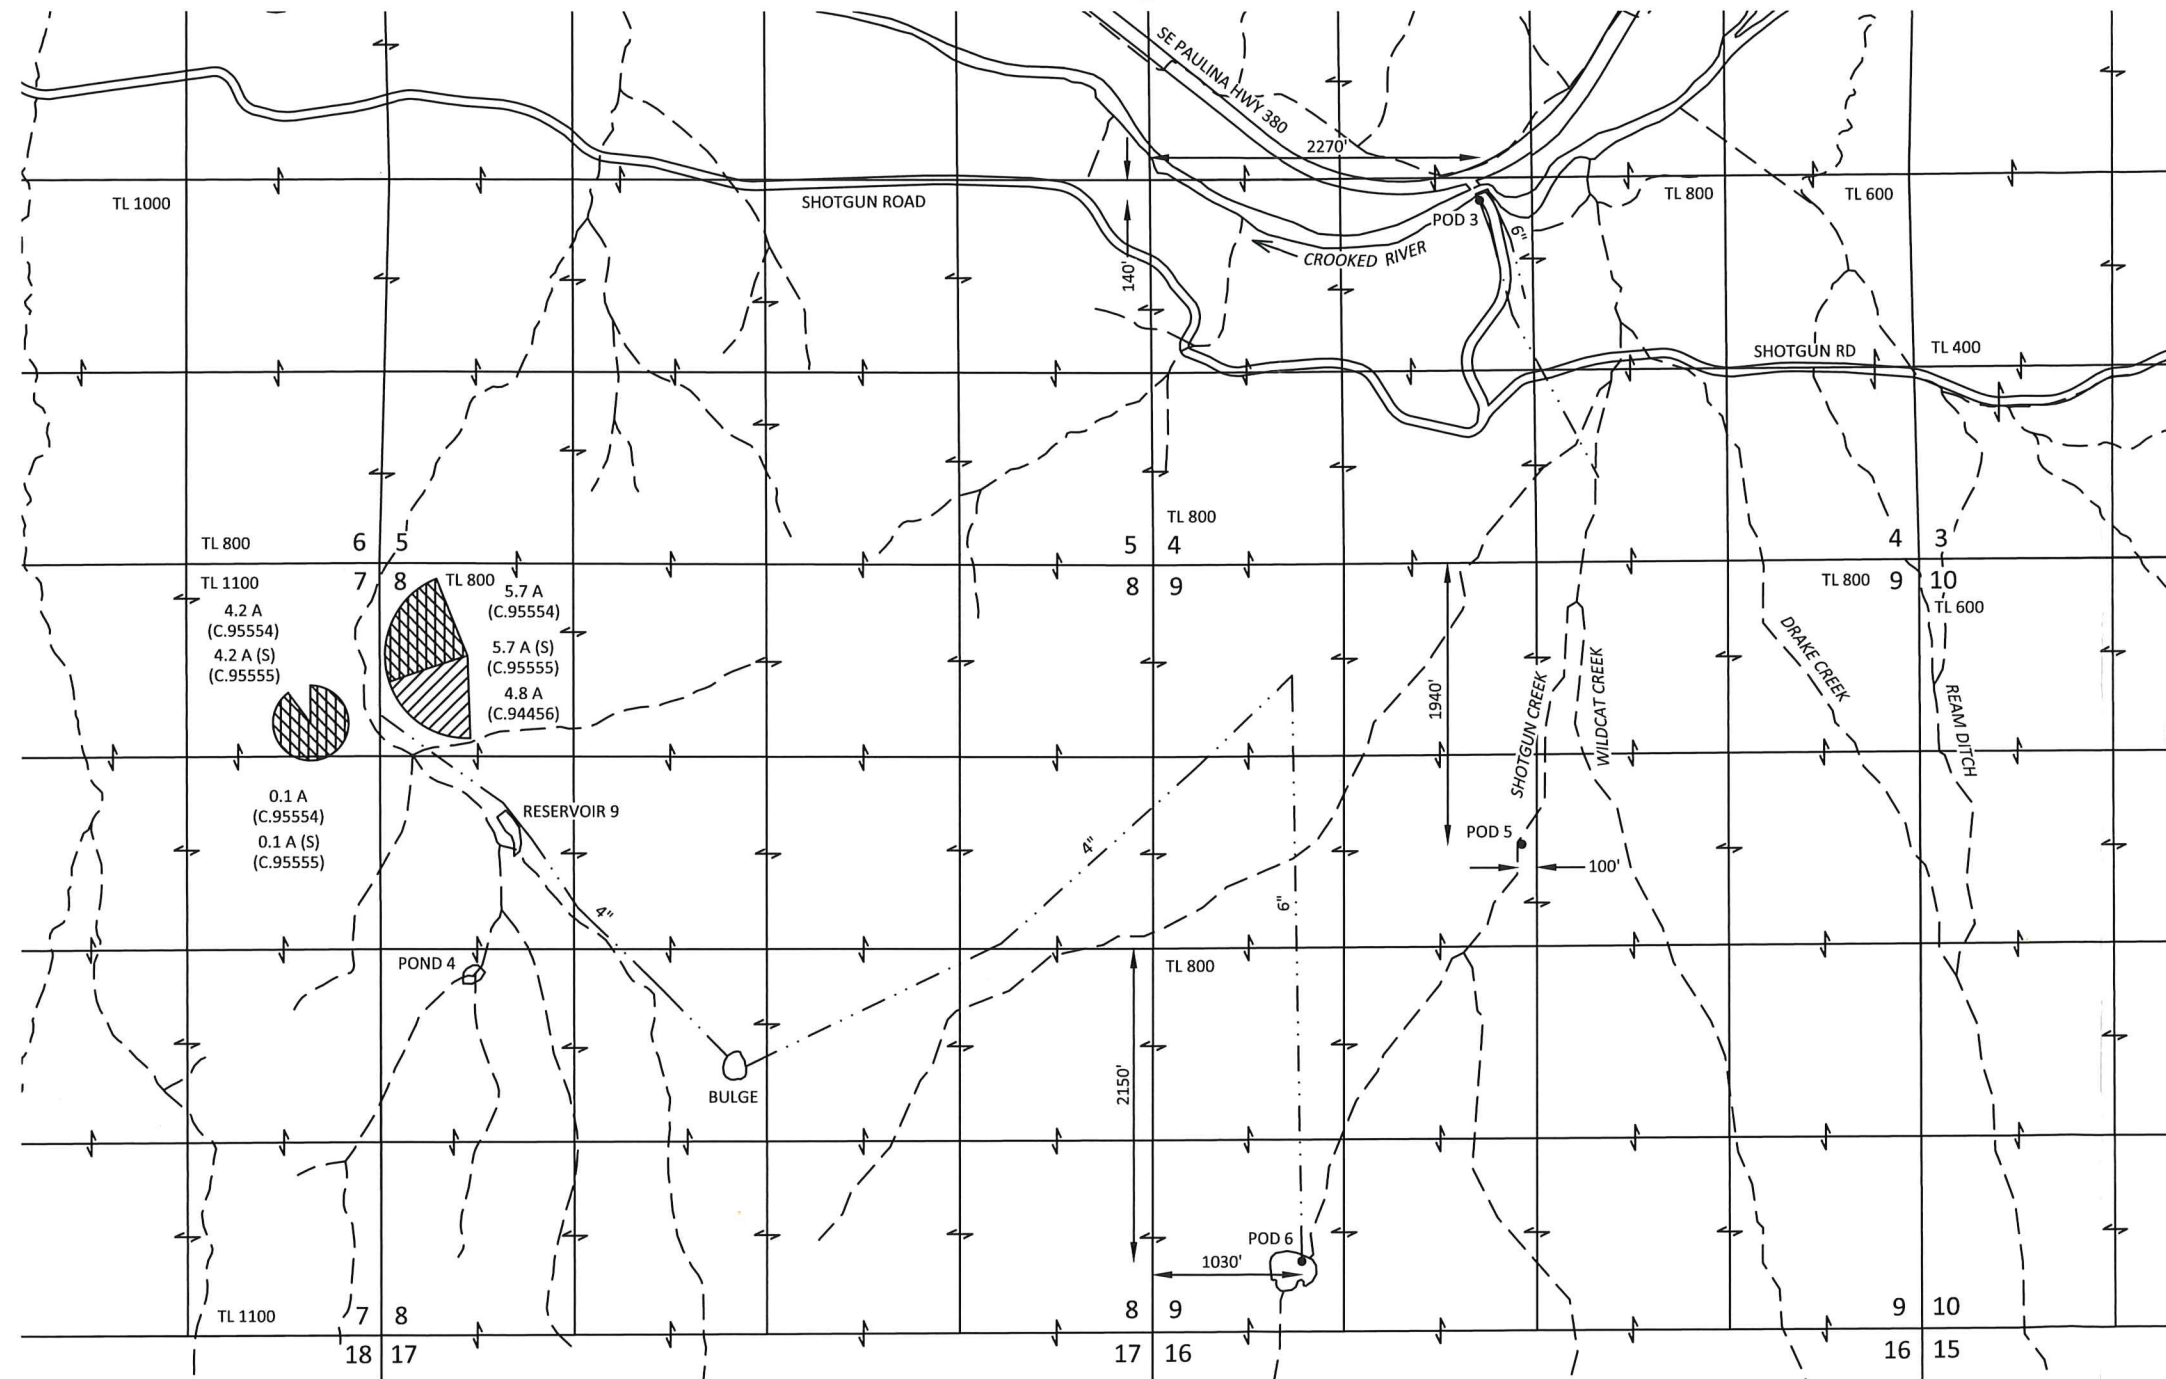Sections 4, 7, 8 & 9, T17S, R20E, W.M.,
Crook County, Oregon


TRANSFER APPLICATION MAP
TO LANDS
Shotgun Creek Ranch LLC

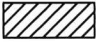

EXPLANATION

- TO LANDS**
-  CERTIFICATE 94456
PRIORITY: 1889
IRRIGATION - 4.8 ACRES
 -  CERTIFICATE 95554
PRIORITY: 1889
IRRIGATION - 10.0 ACRES
 -  CERTIFICATE 95555
PRIORITY: 5/23/1961
SUPPLEMENTAL IRRIGATION (S) - 10.0 ACRES
 -  POINT OF DIVERSION (POD)
 -  PIPE (APPROXIMATE)

NOTE: Not all acres of irrigation for Certificate 94456 are shown

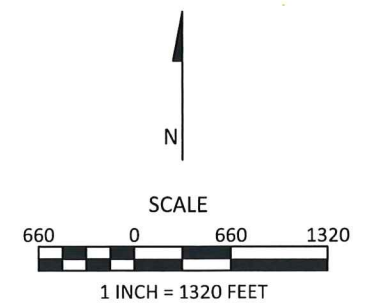

December 1, 2021

This map is not intended to provide legal dimensions or locations of property ownership lines

Figure 2

KPFF 170014.36

SKOOKUM
WATER ASSOCIATES INC

1626 VICTORIAN WAY
EUGENE, OR 97401
(503) 319-8926


RECEIVED

JAN 07 2022






OWRD

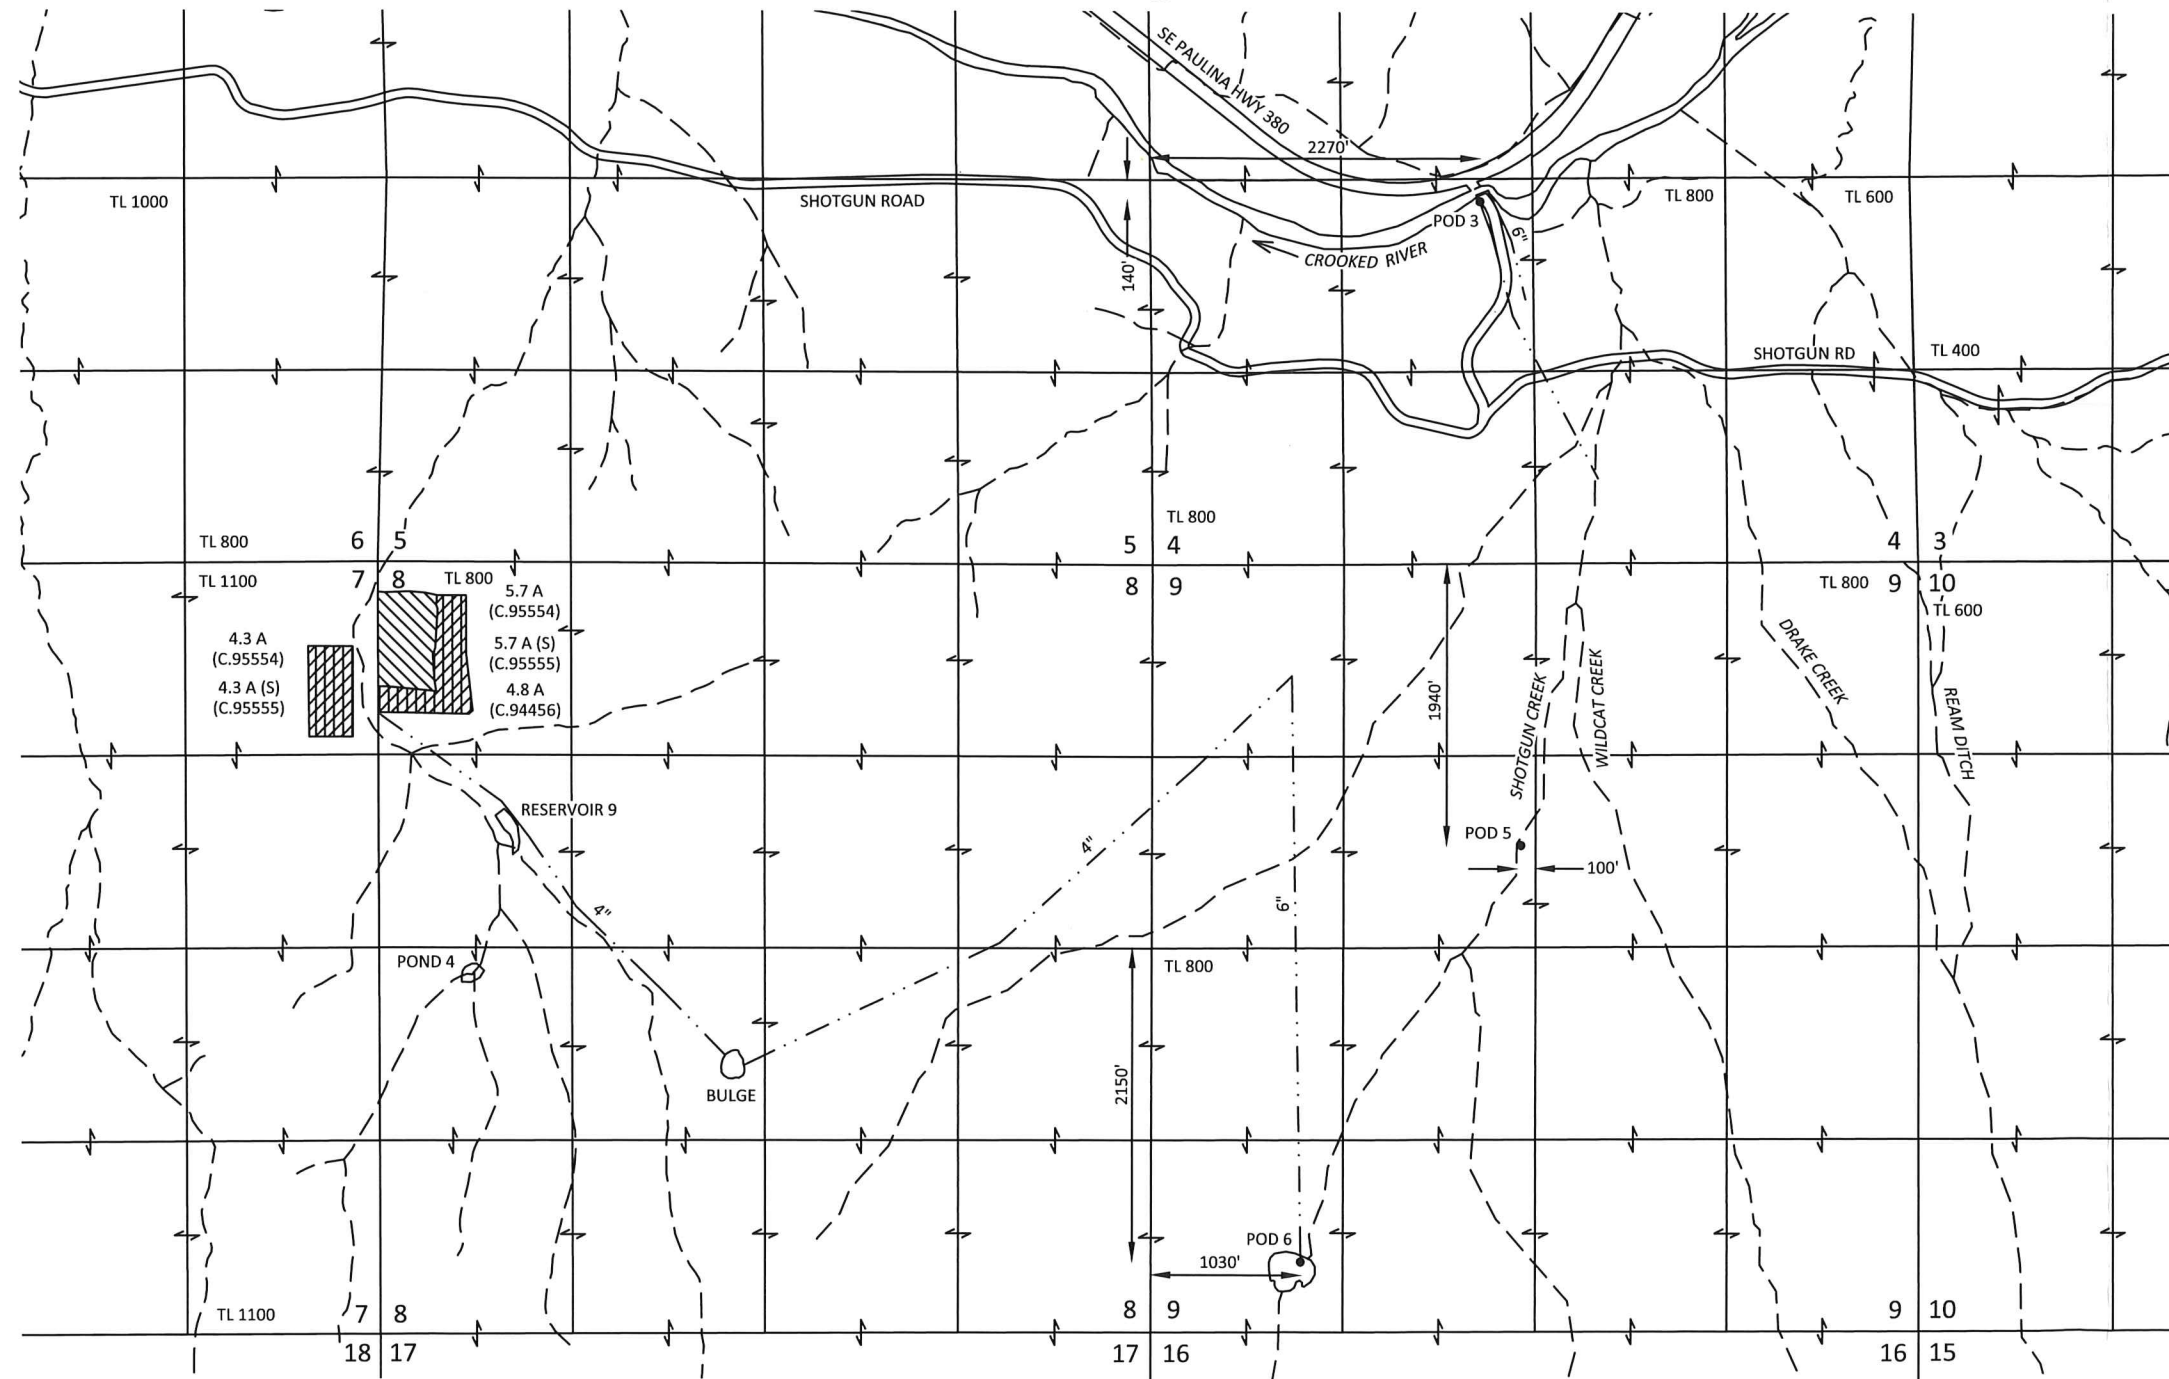Sections 4, 7, 8 & 9, T17S, R20E, W.M.,
Crook County, Oregon


TRANSFER APPLICATION MAP
FROM LANDS
Shotgun Creek Ranch LLC



CERTIFIED WATER RIGHT EXAMINER
439
Steven R. Bruce
STEVEN R. BRUCE
JUNE 13, 1997
STATE OF OREGON
Expires 12/31/2023

 - EXPLANATION
- FROM LANDS (F)
-  CERTIFICATE 94456
PRIORITY: 1889
IRRIGATION - 4.8 ACRES
 -  CERTIFICATE 95554
PRIORITY: 1889
IRRIGATION - 10.0 ACRES
 -  CERTIFICATE 95555
PRIORITY: 5/23/1961
SUPPLEMENTAL IRRIGATION (S) - 10.0 ACRES
 -  POINT OF DIVERSION (POD)
 -  PIPE (APPROXIMATE)

NOTE: Not all acres of irrigation for Certificate 94456 are shown

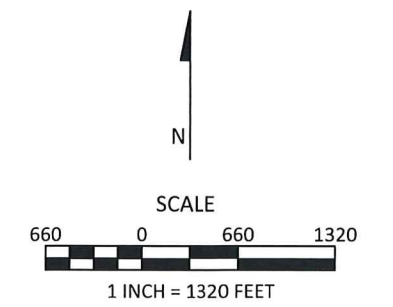

December 1, 2021

This map is not intended to provide legal dimensions or locations of property ownership lines

Figure 1

KPFF 170014.36
SKOOKUM
WATER ASSOCIATES INC
1626 VICTORIAN WAY
EUGENE, OR 97401
(503) 319-8926

RECEIVED
JAN 07 2022
OWRD