
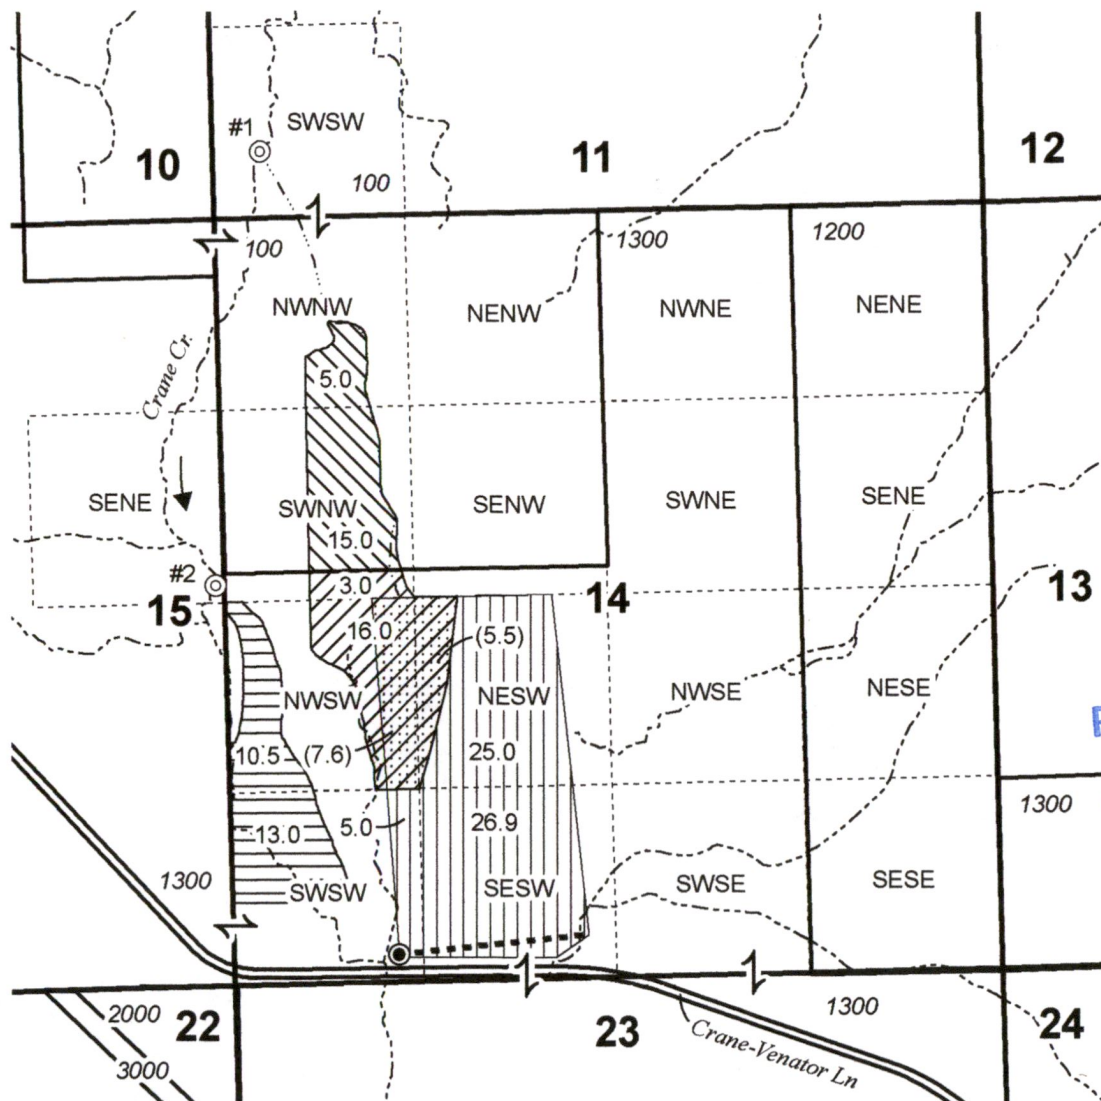


Well Location:
200' N, 1150' E of SW Cor of Sec 14

POD Locations:
#1: 460' N, 320' E of SW Cor Sec 11
#2: 100' N, 60' W of W 1/4 Cor Sec 14

**T25S R34E, WM
HARNEY COUNTY, OR**

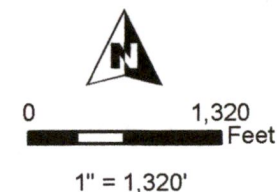


- ⊙ POD
- Well
- Creek
- Pipeline
- - - - - Ditch
- POU IR SW C-6879 1885 "OFF"
- POU IR SW C-6879 1885 "UNCHANGED"
- POU IR SW C-6881 1887 "OFF"
- POU (IS) GW C-64251 4-22-1982 "OFF"
- POU IR GW C-64251 4-22-1982 "OFF"
- Section
- Quarter Quarter
- Tax Lot

RECEIVED

JAN 18 2022

OWRD

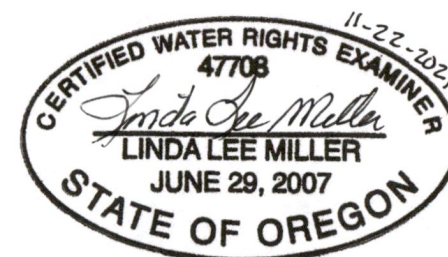

RENEWAL DATE 12/31/2022



**PERMANENT TRANSFER "OFF" MAP
NOMARCO, LLC**

Date: 11/11/2021

C-6879, C-6881, & C-64251

This map is not intended
to provide legal dimensions
or locations of property
ownership lines.



WATER RIGHT SERVICES, LLC
PO BOX 1830, BEND, OR 97709
WWW.OREGONWATER.US CCB # 197121
johnshort@usa.com 541-389-2837

**T25S R34E, WM
HARNEY COUNTY, OR**

Well Location:
200' N, 1150' E of SW Cor of Sec 14

POD Locations:
#1: 460' N, 320' E of SW Cor Sec 11

#2: 100' N, 60' W of W 1/4 Cor Sec 14

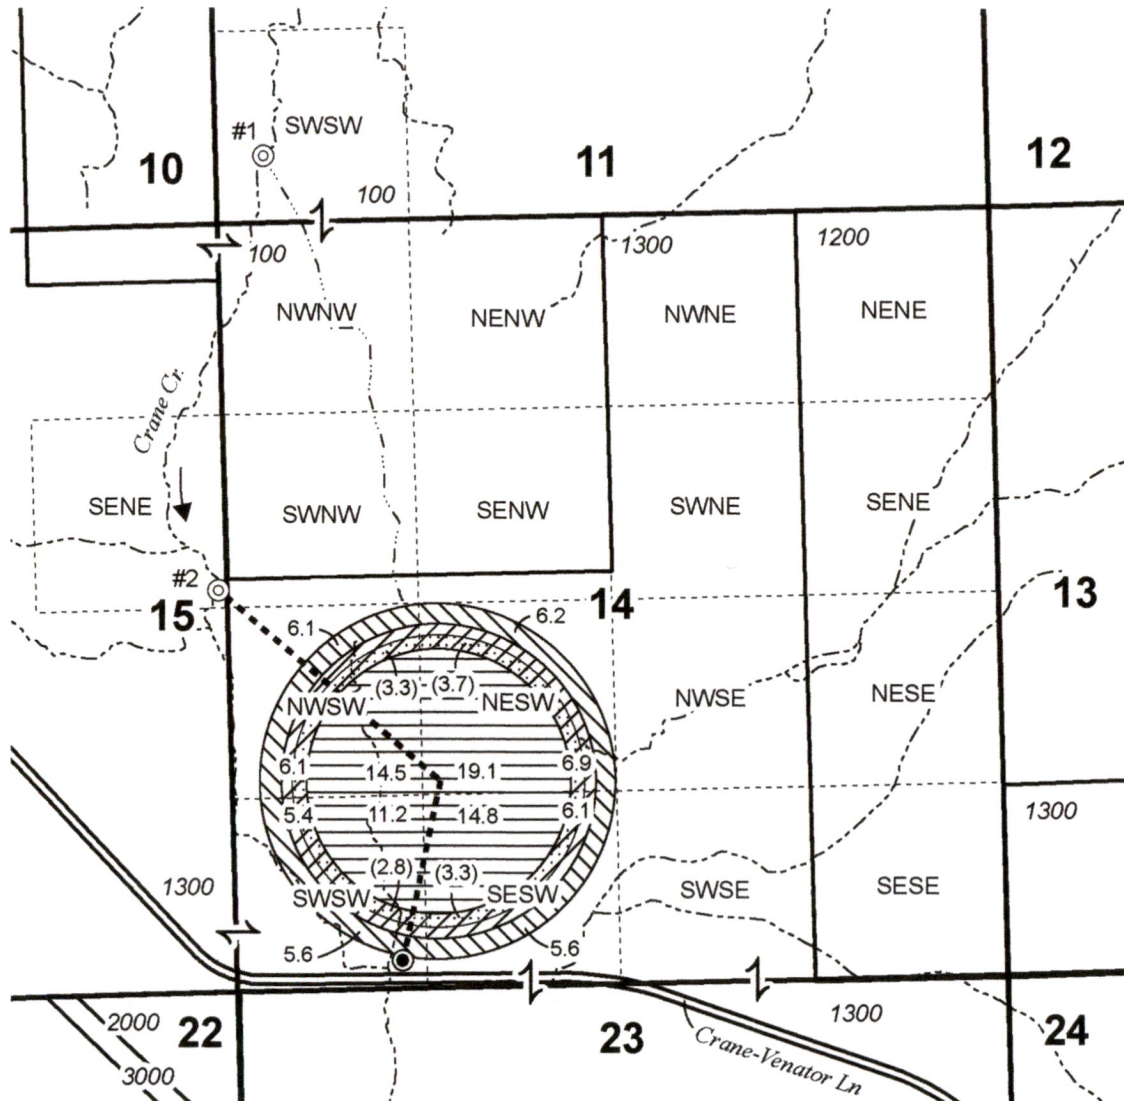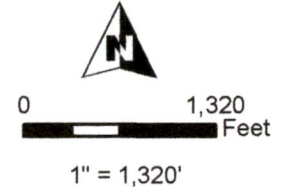


- ⊙ POD
- Well
- Pipeline
- Creek
- Ditch
- POU IR SW C-6879 1885 "ON"
- POU IR SW C-6881 1887 "ON"
- POU IR GW C-64251 4-22-1982 "ON"
- POU (IS) GW C-64251 4-22-1982 "ON"
- Section
- Quarter Quarter
- Tax Lot

RECEIVED

JAN 18 2022

OWRD

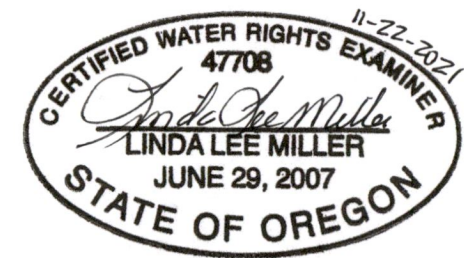

RENEWAL DATE 12/31/2022

**PERMANENT TRANSFER "ON" MAP
NOMARCO, LLC**

Date: 11/11/2021

C-6879, C-6881, & C-64251

This map is not intended
to provide legal dimensions
or locations of property
ownership lines.

WATER RIGHT SERVICES, LLC
PO BOX 1830, BEND, OR 97709
WWW.OREGONWATER.US CCB # 197121
johnshort@usa.com 541-389-2837

NOMARCO AERIAL

2016 Google Earth Imagery

Legend

11

12

14

13

23

24

T25S R34E

RECEIVED
JAN 18 2022
OWRD

Survey
Google Earth

Crane-Venator Rd

2000 ft

