


G-9020

57229
75845
T8045
76468
T8330

T.27S., R.19E., W.M.

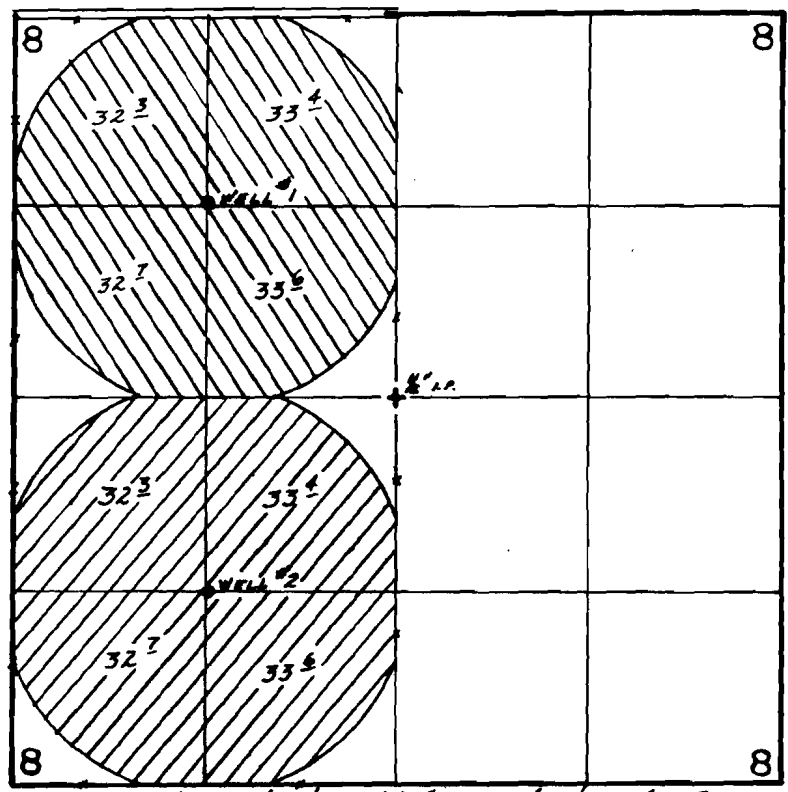

WELLS LOC.: #1-1340' N. & 1320' W., #2-1320' S. & 1300' W., BOTH FROM C 1/4 COR. SEC. 8.

 Well #1
 Well #2

SCALE: 1" = 1320'

FINAL PROOF SURVEY UNDER

Application No. G-9781. Permit No. G-9020...
IN NAME OF

.....FLOWEREE FARMS, INC.....

Surveyed Oct. 11, 1985, by B.W. BISHOP.....

1/25/88 BWS

PTS 1985-L (EMBURO)


T27S R19E, WM,
LAKE COUNTY, OR



0 1,320 Feet

1" = 1,320'

19865

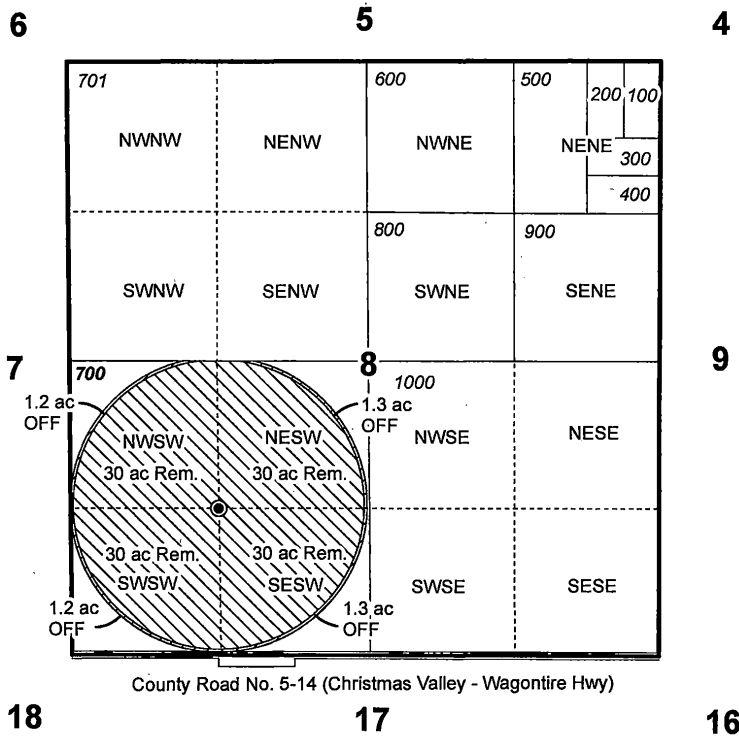

- Well 2 (LAKE 1165)
- POU IR C-76468 "OFF" 6-11-1980
- POU IR C-76468 "REMAINING" 6-11-1980
- Section
- - - - Quarter Quarter
- Tax Lot

Well 2 (LAKE 1165) Location:
1320' S, 1300' W of Center 1/4 Cor

RECEIVED

NOV 04 2021

OWRD



RENEWAL DATE 12/31/2020



TRANSFER "OFF" MAP
Nofziger Ranch

C-76468 "OFF" MAP

Date: 6/20/2020

This map is not intended
to provide legal dimensions
or locations of property
ownership lines.

WATER RIGHT SERVICES, LLC
PO BOX 1830, BEND, OR 97709
WWW.OREGONWATER.US CCB # 197121
johnshort@usa.com 541-389-2837