


POD LOCATION DESCRIPTION
 Center of Dam
 Located 3200 feet South and 770 feet West from the NE corner
 of Section 12, Township 7 South, Range 4 West (W.M.)

LEGEND

- Staff Gage
- ⊙ Point of Diversion (POD)
- ▨ Place of Use (POU)
- - - Donation Land Claim (DLC)
- - - Government Lot (GL)
- All Other Features**
- ⊕ Tax Lot
- ~ Watercourse

Date: November 4, 2021
 Data Sources: Polk Co., ESRI, OGIC, USGS

Certified Water Rights Examiner Stamp

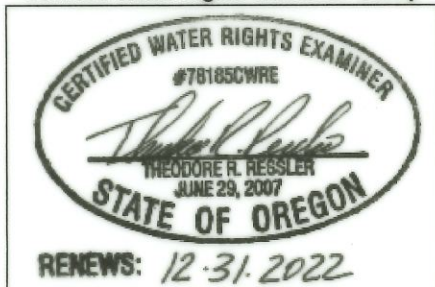

RECEIVED


DEC 09 2021

OWRD

COBU MAP # 1321

Claim of Beneficial Use
Permit R-15093 (Application R-86760)
A Water Right in the Name of
Roserock Middle LLC

Polk County
 Township 7 South, Range 4 West (W.M.)

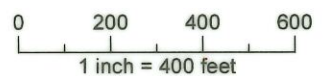

COBU MAP # 1321