



**T16S R16E, WM
CROOK COUNTY, OR**

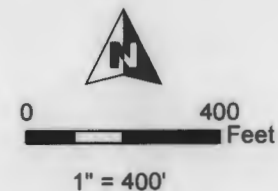

- Well
- Pipeline
- POU IR
- Township
- Section
- Quarter Quarter
- Tax Lot

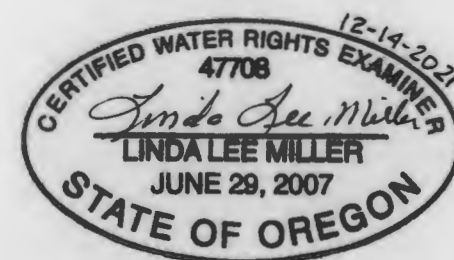

RENEWAL DATE 12/31/2022


RECEIVED

DEC 27 2021

OWRD



WATER RIGHT SERVICES, LLC
PO BOX 1830, BEND, OR 97709
WWW.OREGONWATER.US CCB # 197121
johnshort@usa.com 541-389-2837

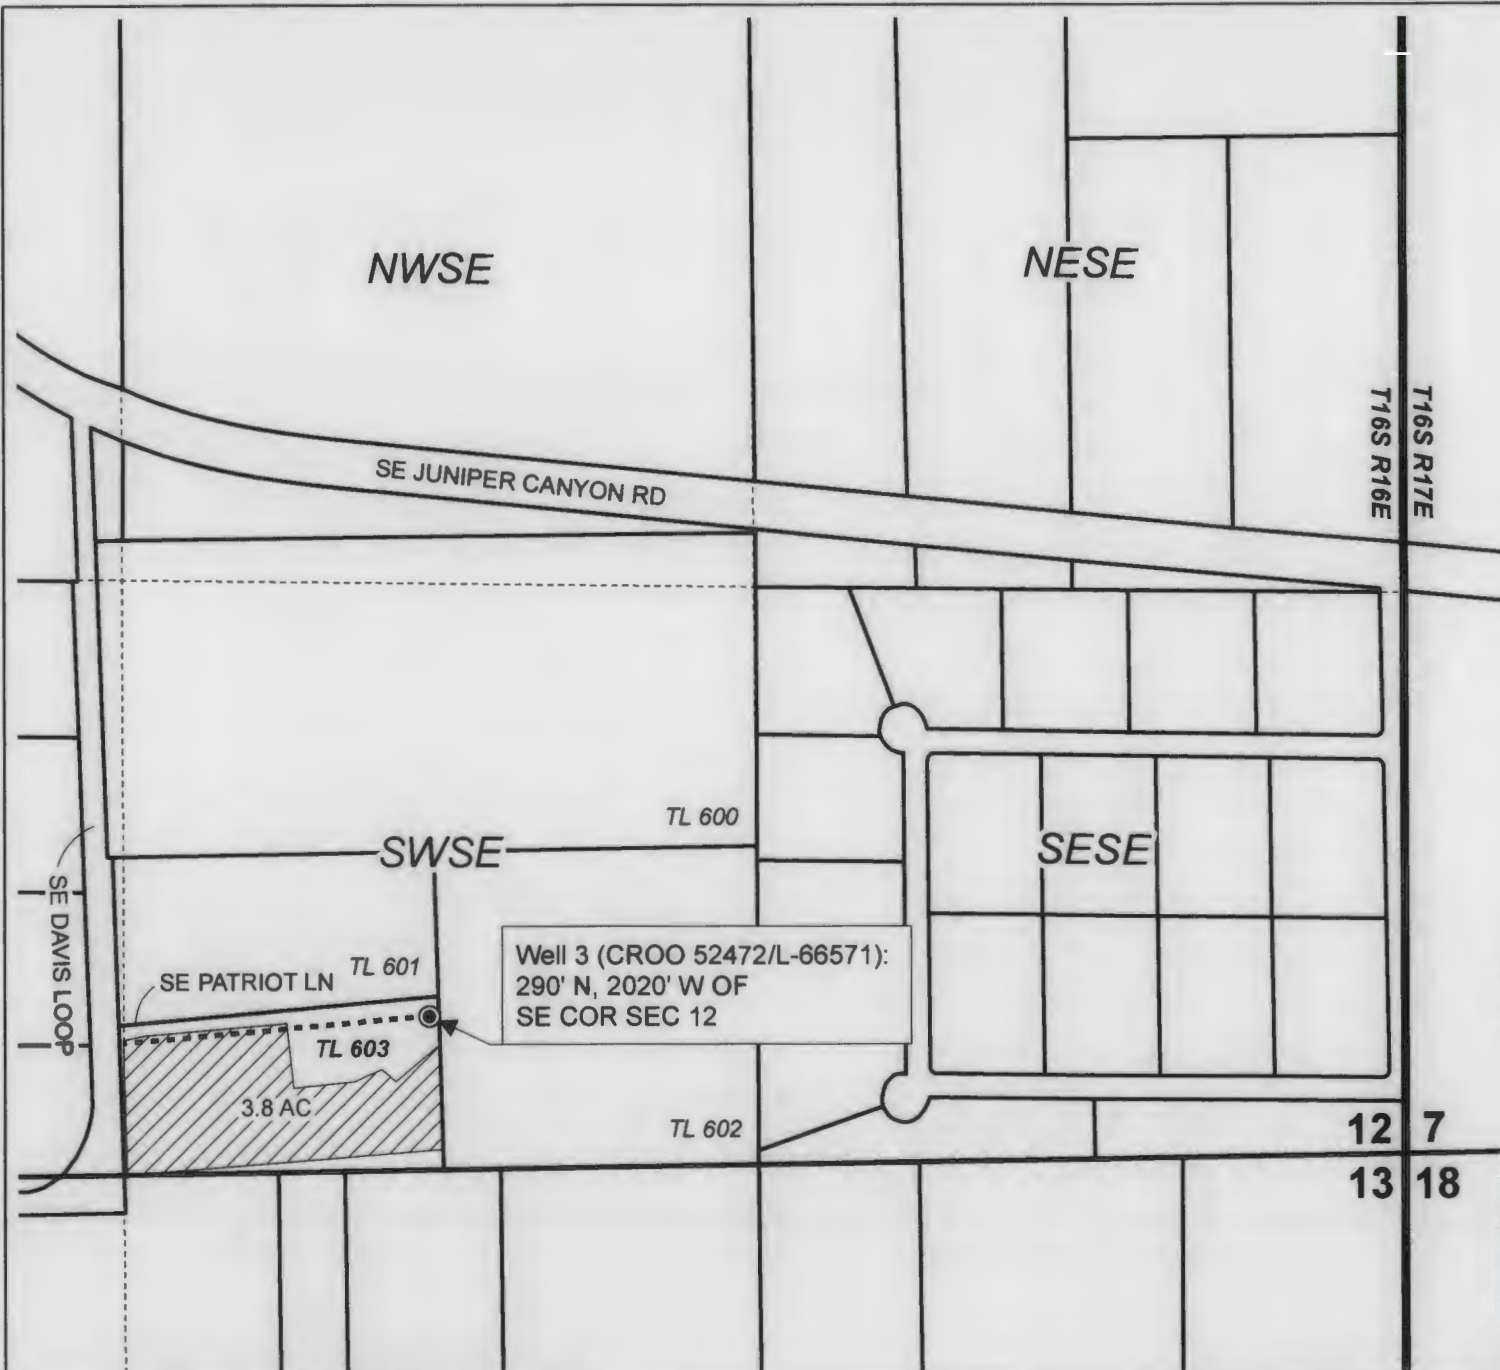

**CLAIM OF BENEFICIAL USE MAP
Wayne and Barbara Bennett**

Date: 12/10/2021

Ap G-14595

Permit G-18360

This map is not intended
to provide legal dimensions
or locations of property
ownership lines.