


# Claim of Beneficial Use Map (T-9873)

CERTIFIED WATER RIGHT EXAMINER  
 72665  
*Gabriel M. Williams*  
 GABRIEL M. WILLIAMS  
 JULY 10, 2018  
 STATE OF OREGON  
 RENEWS: 6/30/22

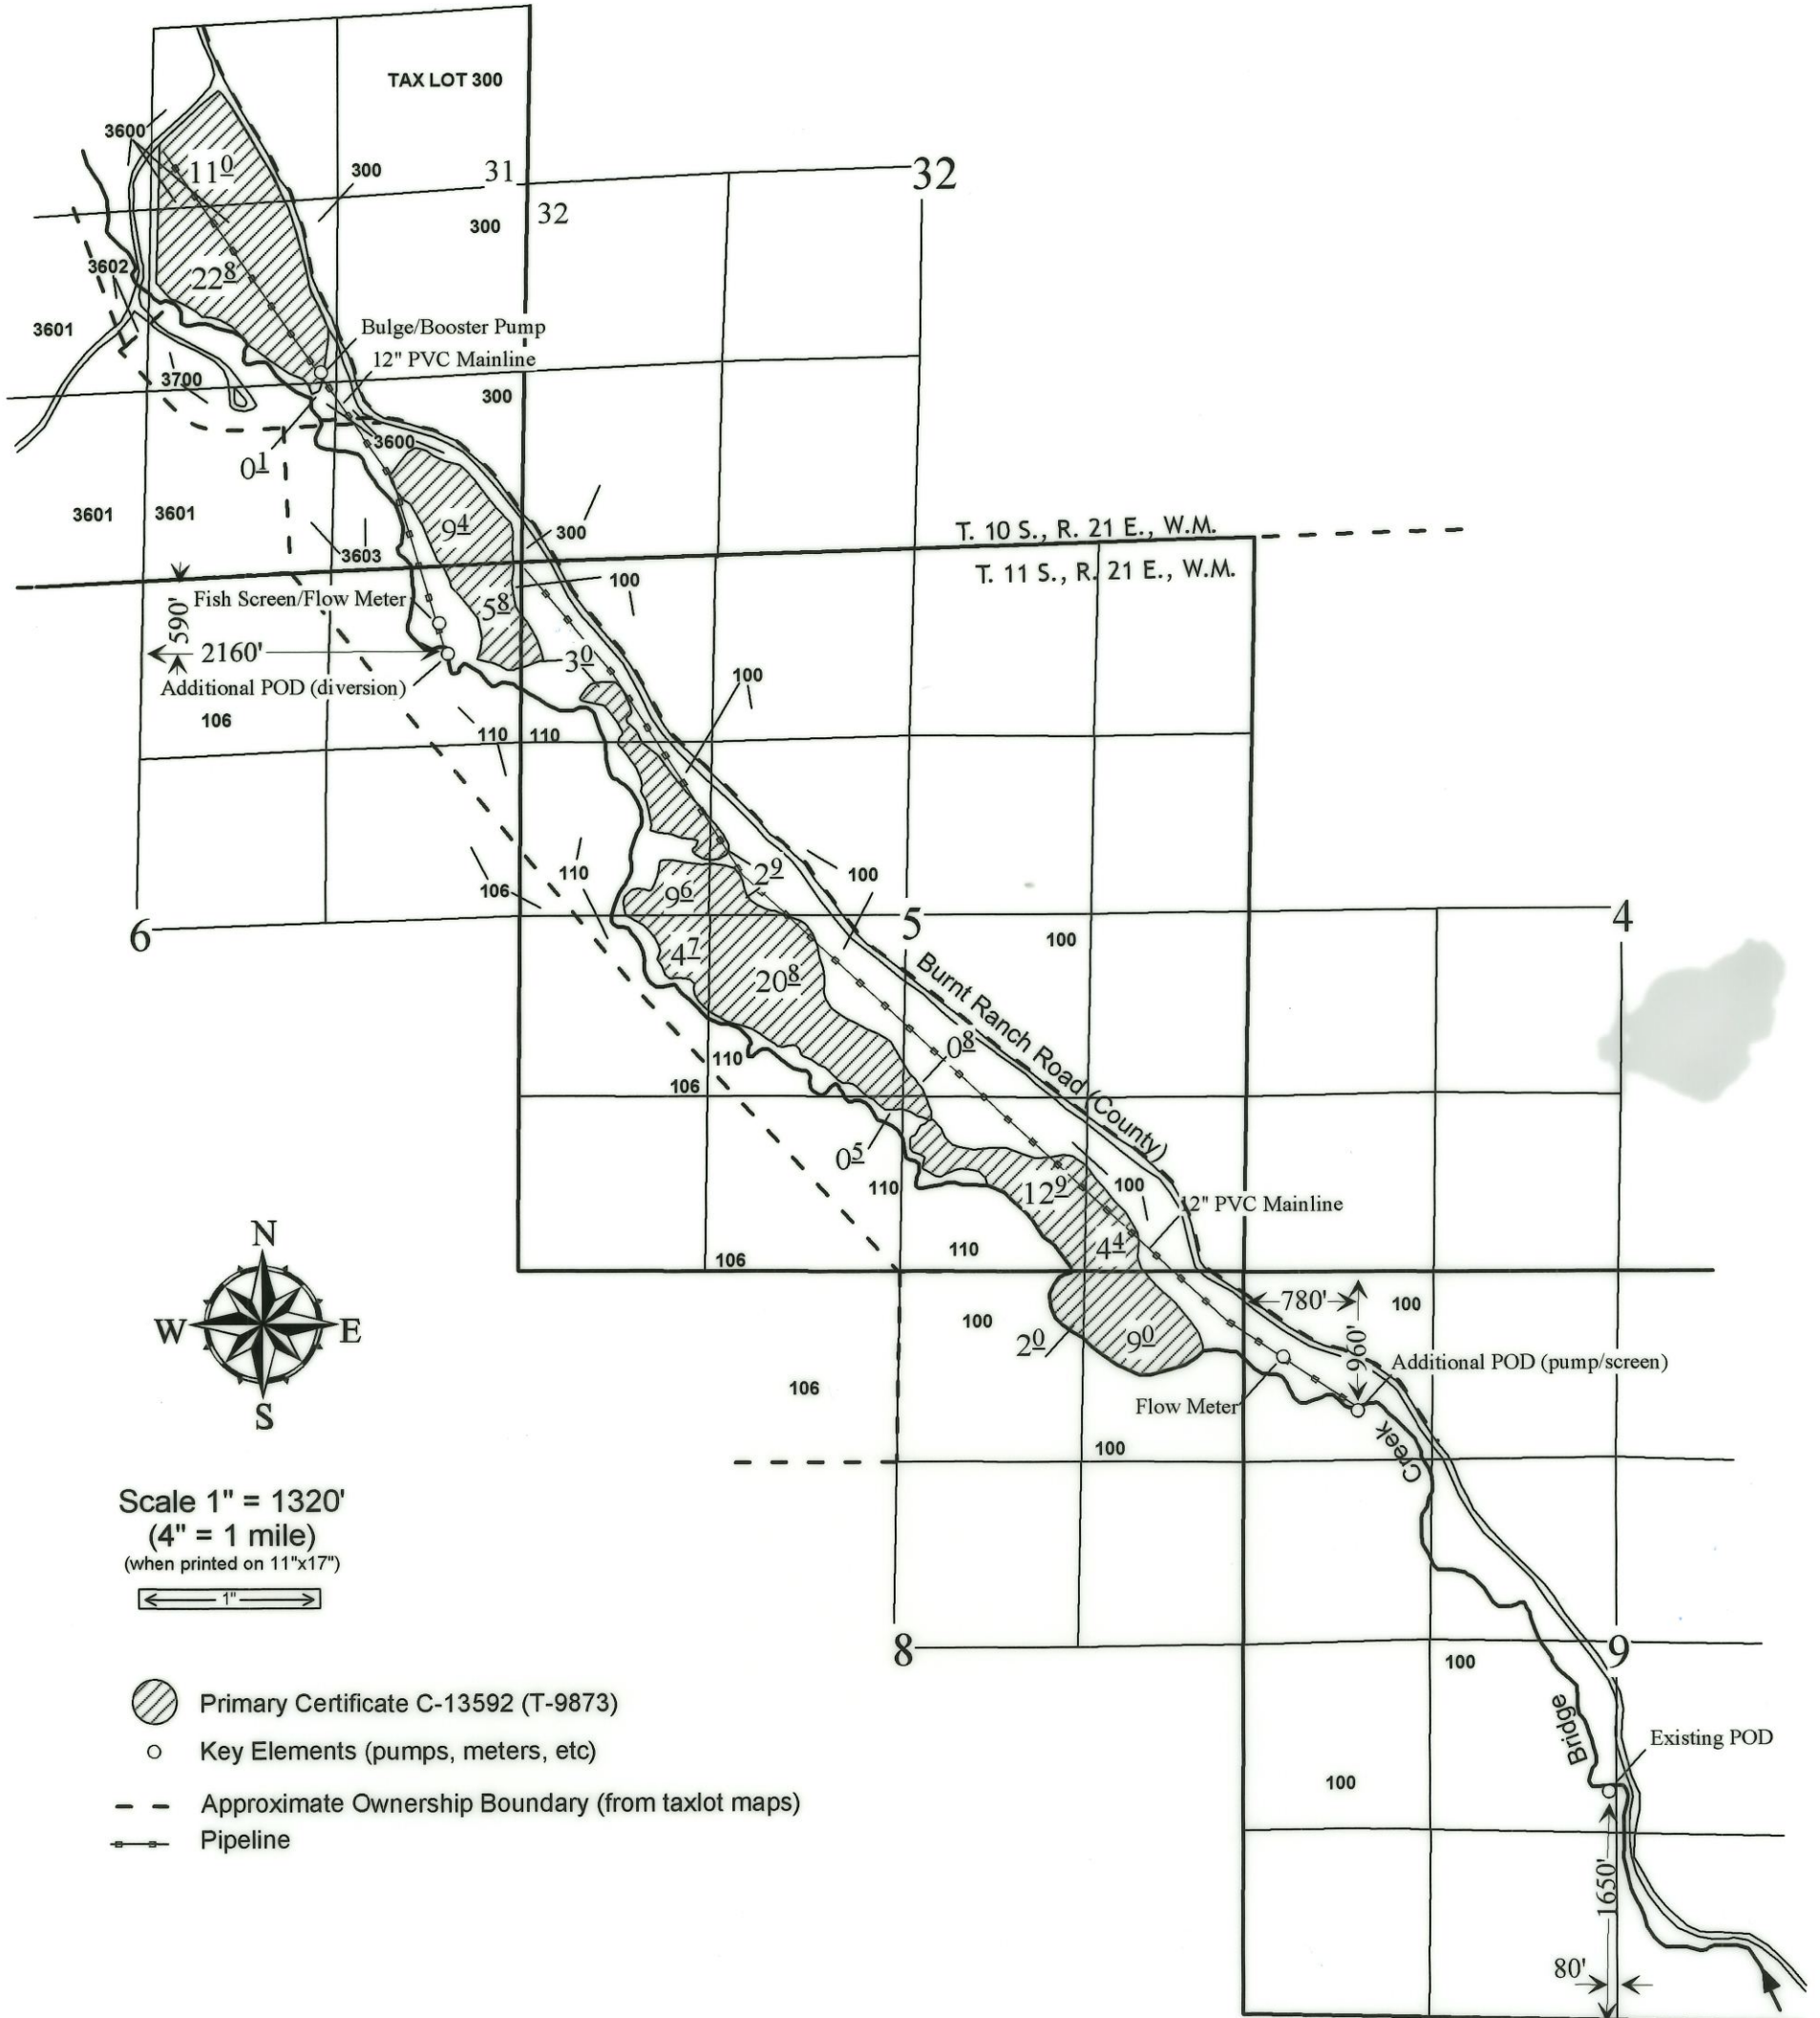

Scale 1" = 1320'  
 (4" = 1 mile)  
 (when printed on 11"x17")

- Primary Certificate C-13592 (T-9873)
- Key Elements (pumps, meters, etc)
- Approximate Ownership Boundary (from taxlot maps)
- Pipeline

This map is for the purpose of locating a water right only and is not intended to provide legal dimensions or locations of property ownership lines.

Federal Land Ownership Taxlots: 100, 106, 110, 300, 3601, 3602, 3603, 3700

*COBU MAP # 2022*

RECEIVED  
 APR 15 2022  
 OWRD

*COBU MAP # 2022*

S6-1.1  
 DRAWING:  
 DRAWN BY: GMMW  
 SHEET TITLE:  
 COBU Map  
 PROJECT:  
 COBU  
 PROJECT LOCATION:  
 MITCHELL, OREGON  
 CLIENT:  
 Bridge Creek Ranch, LLC

**RSI** Resource Specialists INC.  
 1180 SW LAKE RD, STE 202 (541) 771-6911  
 REDMOND, OR 97756 gabe@RSIengr.com

DRAWING STATUS	DATE	No.	REVISION	DATE
DRAFT	7/13/21			
FINAL	7/28/21			