


T.7S. R.1W. Sec. 6 & 7, W.M.

RECEIVED

NOV 12 2021

OWRD

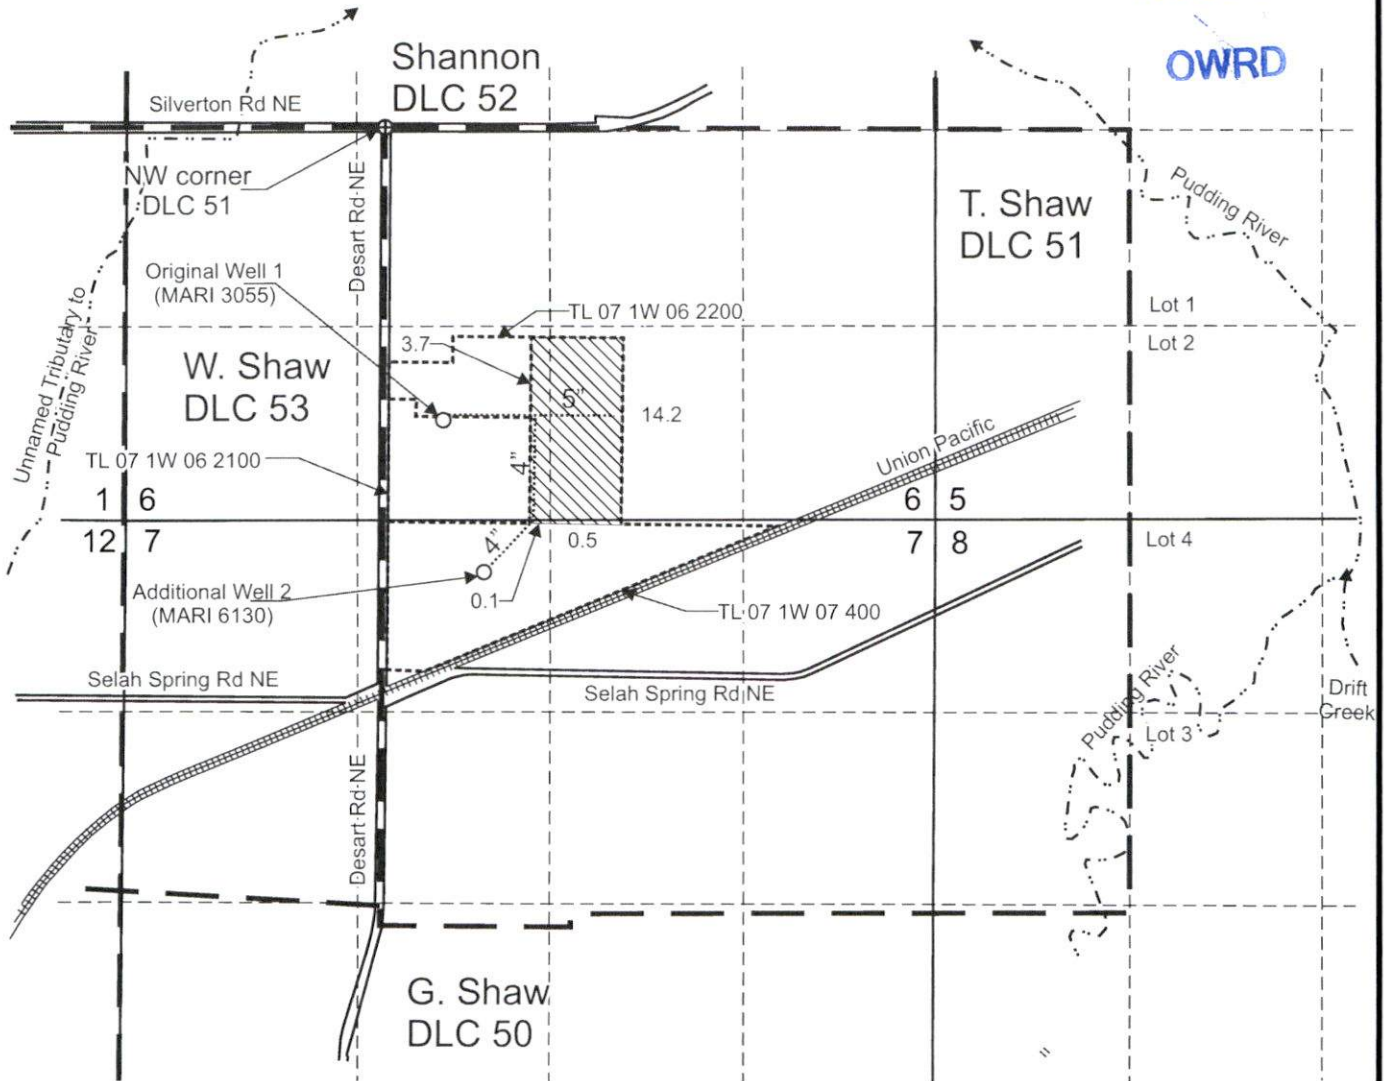

Original Well 1 (MARI 3055) is located 1,980 feet south and 400 feet east from the NW corner, DLC 51.

Additional Well 2 (MARI 6130) is located 3,045 feet south and 665 east from the NW corner, DLC 51.

Area (18.5 Acres) irrigated under T-12982.

Tax lot boundary

Donation Land Claim boundary

Water main line

Scale: 1" = 1,320'



This map was prepared for the purpose of identifying the location of a water right only and is not intended to provide legal dimensions or location of property ownership lines.

Claim of Beneficial Use Map T-12982

Myron and Diane Kuenzi Family Farm LLC
T.7S. R.1W. Sec. 6 & 7, W.M.

Pacific Hydro-Geology Inc.

10/2021