


T. 30 S., R. 4 W., W.M.

SCALE: 1" = 1320'

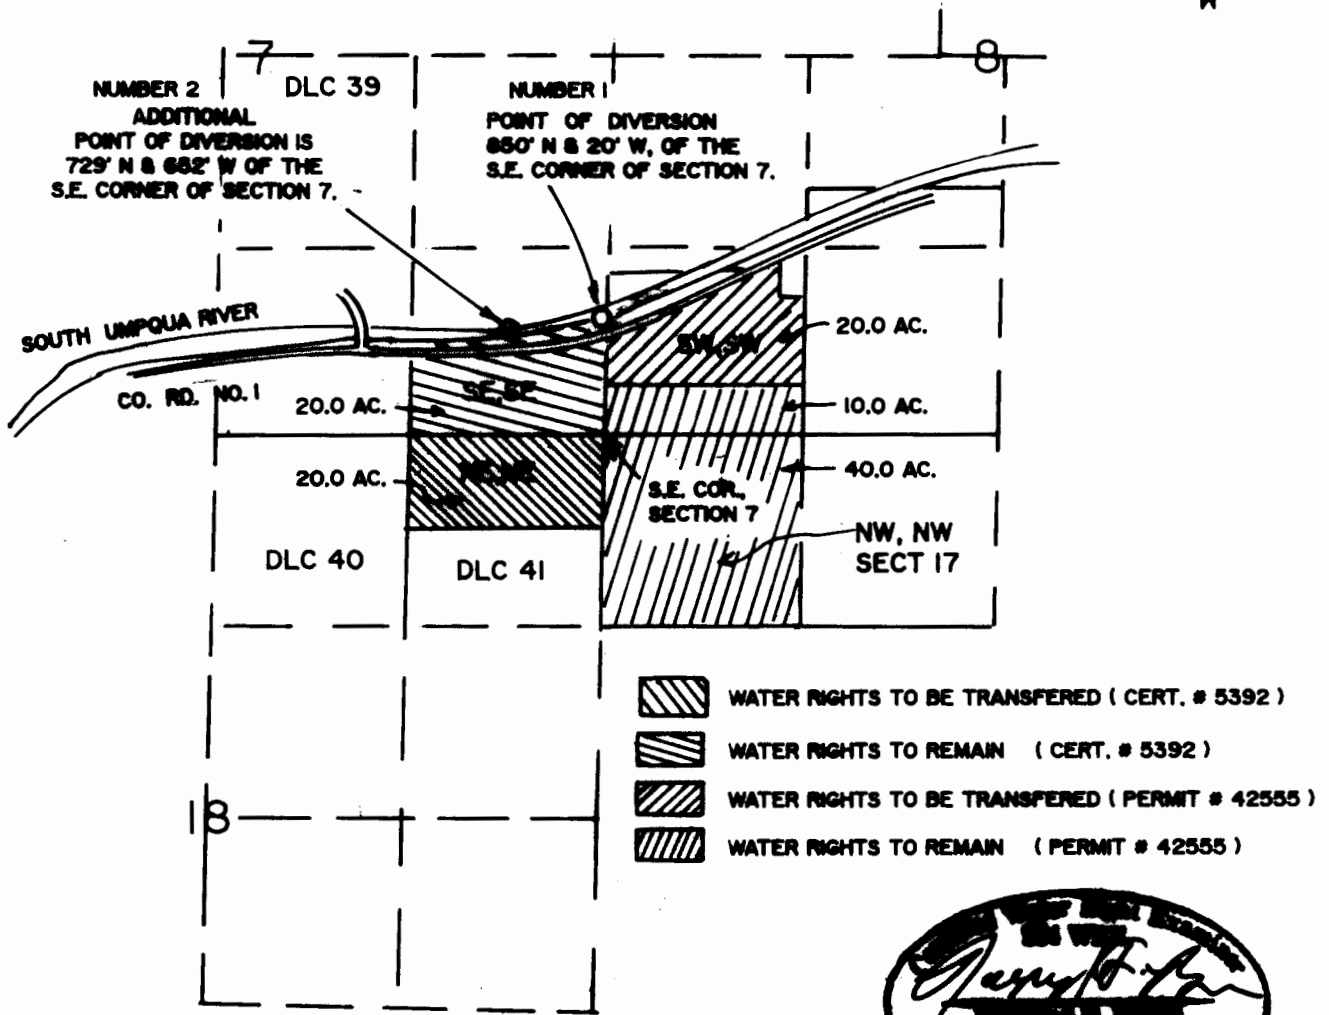

THE PURPOSE OF THIS MAP IS TO IDENTIFY THE LOCATION OF THE WATER RIGHT. IT IS NOT INTENDED TO PROVIDE INFORMATION RELATIVE TO THE LOCATION OF PROPERTY OWNERSHIP BOUNDARY LINES.



FINAL PROOF SURVEY

4615

EXP. 12/31/05

UNDER

42555

44995

Application No. T - 6764 Permit No. 45965

IN NAME OF

ROI JEAN LAURANCE

RECEIVED


Surveyed 9/23/05, by R.F. BROWN

SEP 30 2005

WATER RESOURCES DEPT
SALEM, OREGON

T-6764

T. 30S., R. 4 W., W.M.

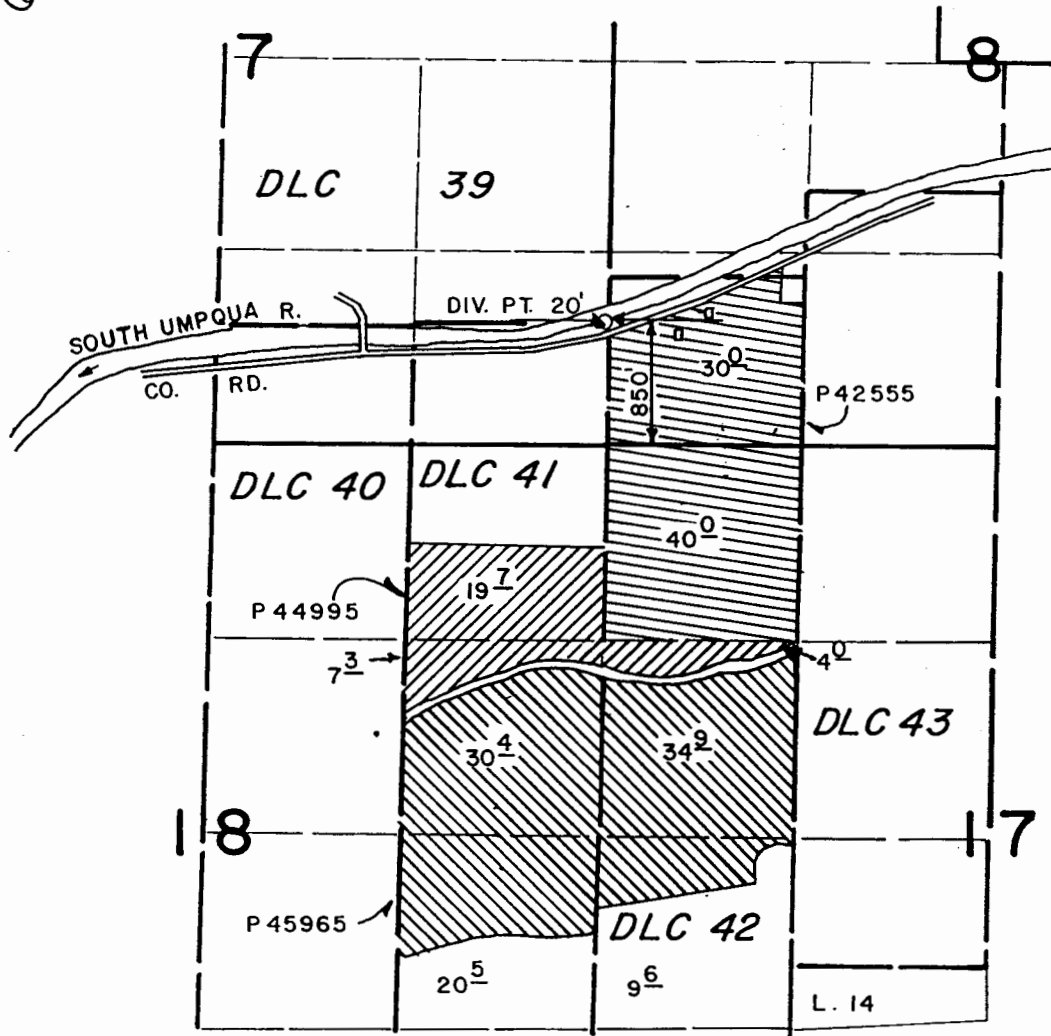

SCALE: 4" = 1 MILE

FINAL PROOF SURVEY
UNDER

	61672	45965
	59876	44995
Application No.	56597	Permit No. 42555

IN NAME OF

HAYDEN L. & ROI JEAN LAURANCE

Surveyed JUNE 24, 1986, by J. M. SCHMORDE