

**CLAIM OF BENEFICIAL USE MAP RECEIVED**  
**FOR: JOHN and/or TINA CYPHERT**  
**BY: NATHAN R. REED, PE, CWRE**  
**T26S, R3W, W.M. SECTION 9**  
**APPLICATION NO. S-88643**  
**PERMIT NO. S-55206**


JUN 29 2020

OWRD



Scale: 1" = 400'

DATE SURVEYED: MAY 28, 2020

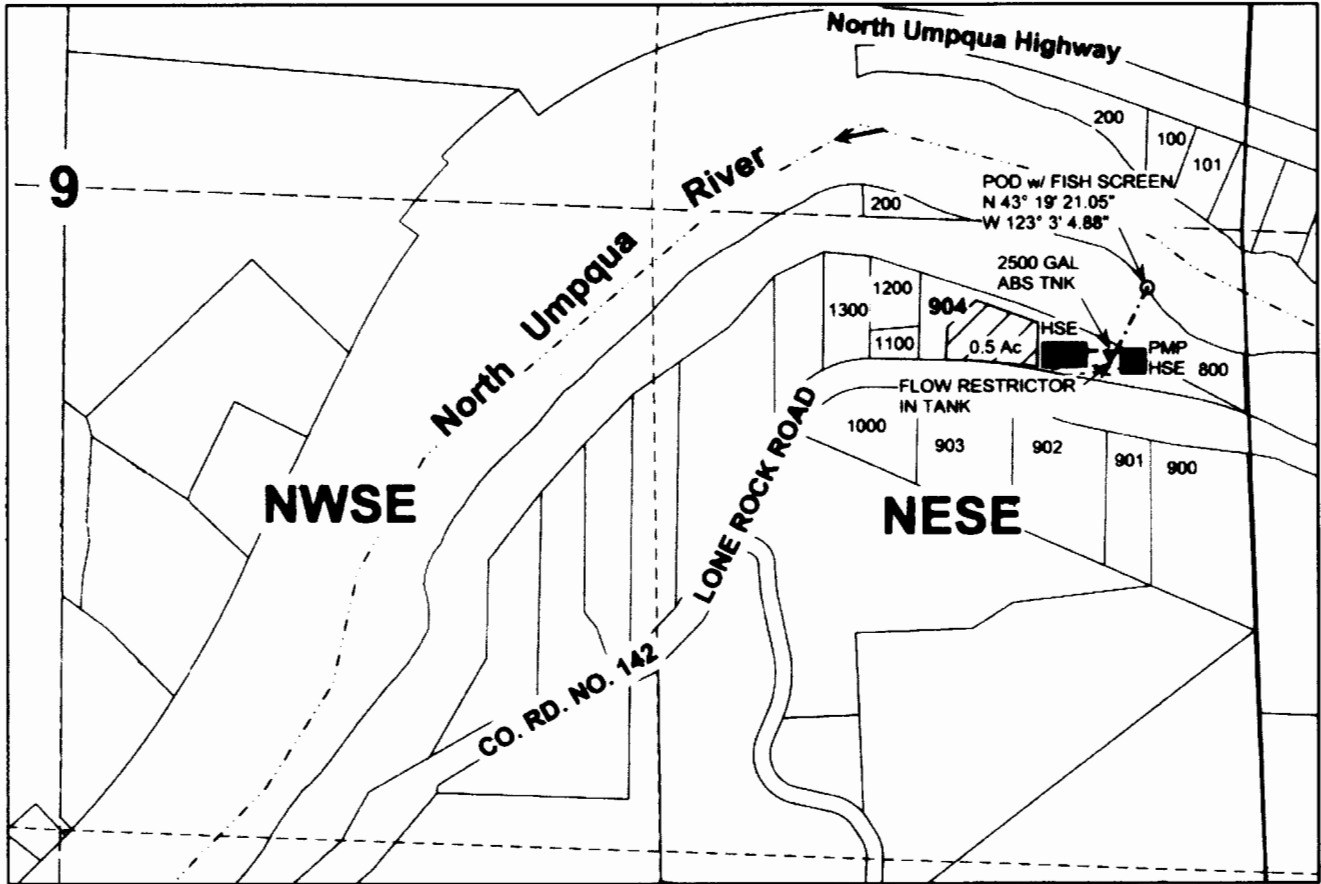


POD LOCATED 130 FEET SOUTH AND 202 FEET WEST OF THE E1/4 CORNER, SECTION 9

**Legend**

-----	River		Irrigation		Section
o	POD		Flow Arrow	-----	Quarter
- - - - -	Pipeline		Structures	- - - - -	Sixteenth
o	Water Tank	.....	Roads		Parcels
▼	Pump				

MAP PREPARED FOR:  
 JOHN & TINA CYPHERT  
 1710 LONE ROCK ROAD  
 GLIDE, OR 97443

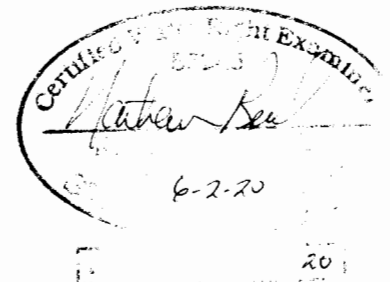

THE PURPOSE OF THIS MAP IS TO IDENTIFY THE LOCATION OF THE WATER RIGHT. IT IS NOT INTENDED TO PROVIDE INFORMATION RELATIVE TO THE LOCATION OF PROPERTY OWNERSHIP BOUNDARY LINES.

MAP PREPARED BY:  
 NATHAN R. REED, PE, CWRE  
 157 W. BODIE STREET  
 ROSEBURG, OR 97471