
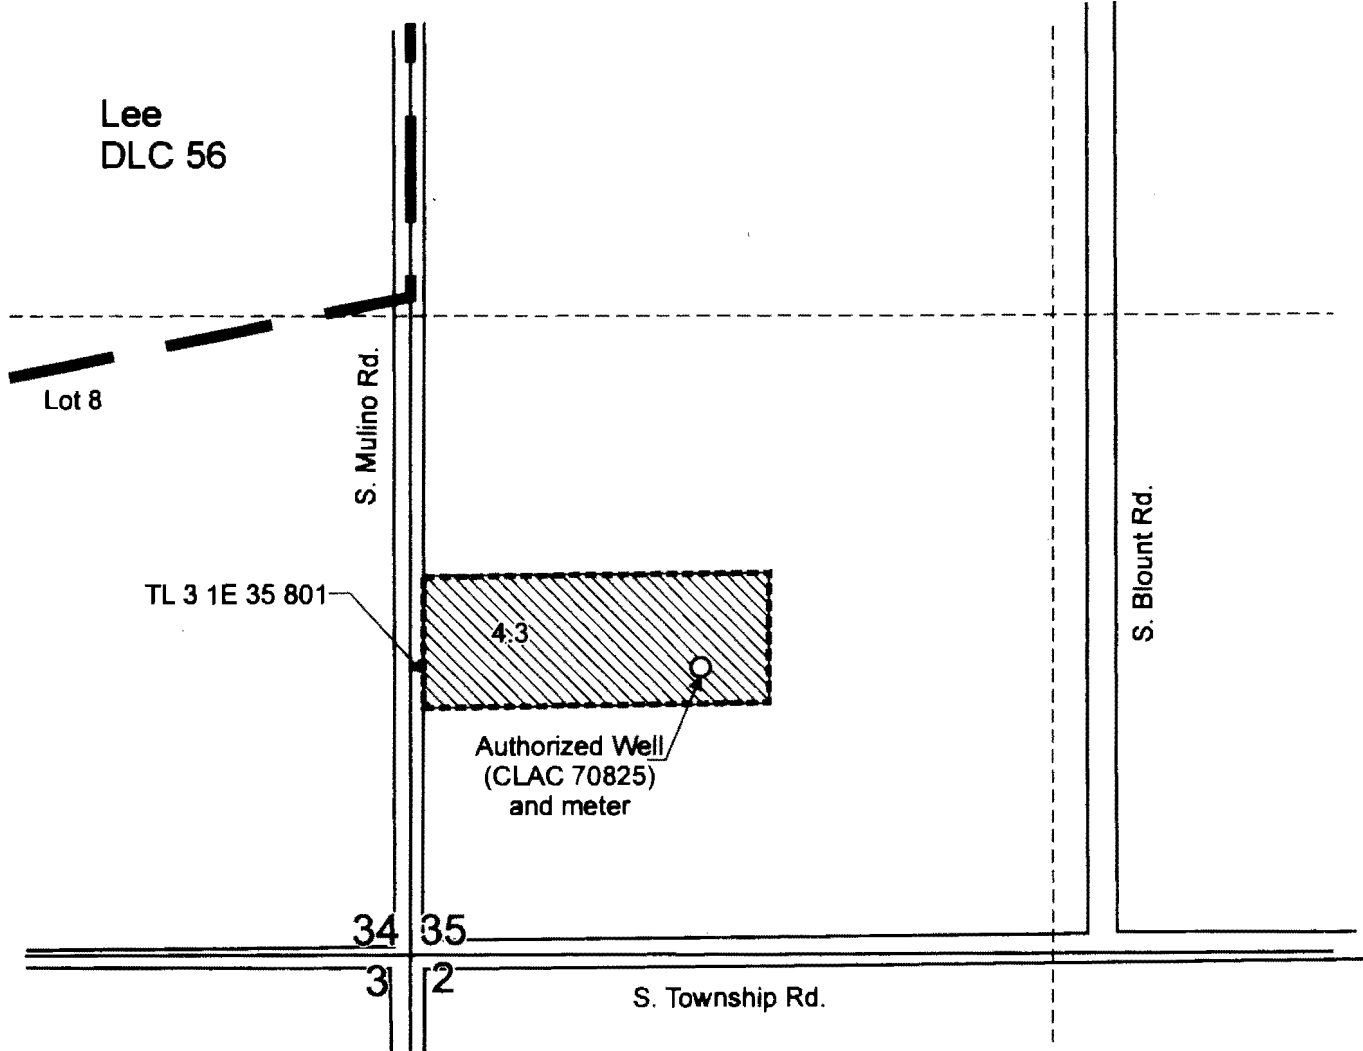


T.3S. R.1E. Section 35, W.M.

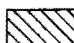



Authorized Well (CLAC 70825) is located 595 feet north and 600 feet east from the SW corner, Section 35.

 Area (4.3 Acres) irrigated under Certificate 34213, affected by this transfer, priority date November 16, 1961.

----- Tax lot boundary

———— Donation Land Claim boundary

Scale: 1" = 400'

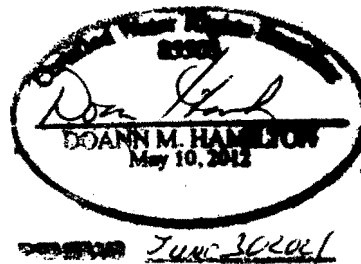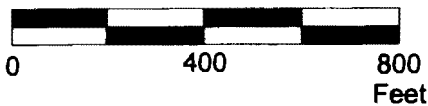

This map was prepared for the purpose of identifying the location of a water right only and is not intended to provide legal dimensions or location of property ownership lines.

**Claim of Beneficial Use Map
T-12212**

Scott and Susan Gustafson
T.3S. R.1E. Section 35, W.M.

Pacific Hydro-Geology Inc.

06/2020

GustafsonCOBUMap.cdr