


**NOTES:**

1. THIS MAP WAS PREPARED FROM FIELD MEASUREMENTS, NAIP 2020 AERIAL PHOTOGRAPH, JACKSON COUNTY TAX MAPS, AND OREGON GLO MAPS.
2. THE PURPOSE OF THIS MAP IS TO IDENTIFY THE LOCATION OF THE WATER RIGHT ONLY, AND IS NOT INTENDED TO PROVIDE DIMENSIONS OR LOCATION OF PROPERTY LINES.
3. DATE OF PRIORITY FOR THIS WATER RIGHT IS 1854.

**POD LOCATION:**

POD 1: T39S, R2E, SEC. 19, W.M., 1500' NORTH & 1890' EAST FROM THE SOUTHWEST CORNER OF SECTION 19.

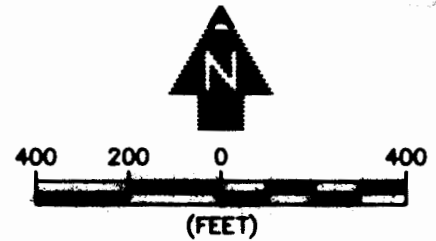

**ADKINS** ENGINEERING & SURVEYING  
 541.884.4666  
 w / AdkinsEngineering.com

1435 ESPLANADE AVENUE, KLAMATH FALLS, OR 97601

SERVING S. OREGON & N. CALIFORNIA

ENGINEERING • SURVEYING • PLANNING • TESTING

**CLAIM OF BENEFICIAL USE AND FINAL PROOF MAP**

FOR  
 BRANDI WAITS  
 T39S, R2E, SEC. 19, WM  
 JACKSON COUNTY, OREGON  
 TRANSFER T-12947