

FINAL PROOF MAP

TO ADD A POINT OF APPROPRIATION
AND PLACE OF USE FOR APPLICATION G-17549

RECEIVED



JUL 16 2020

MIKE PEILA

TOWNSHIP 24 SOUTH, RANGE 30 EAST, W.M.

TAX LOT: 2200 & 3200

OWRD

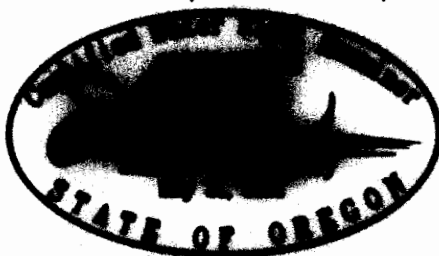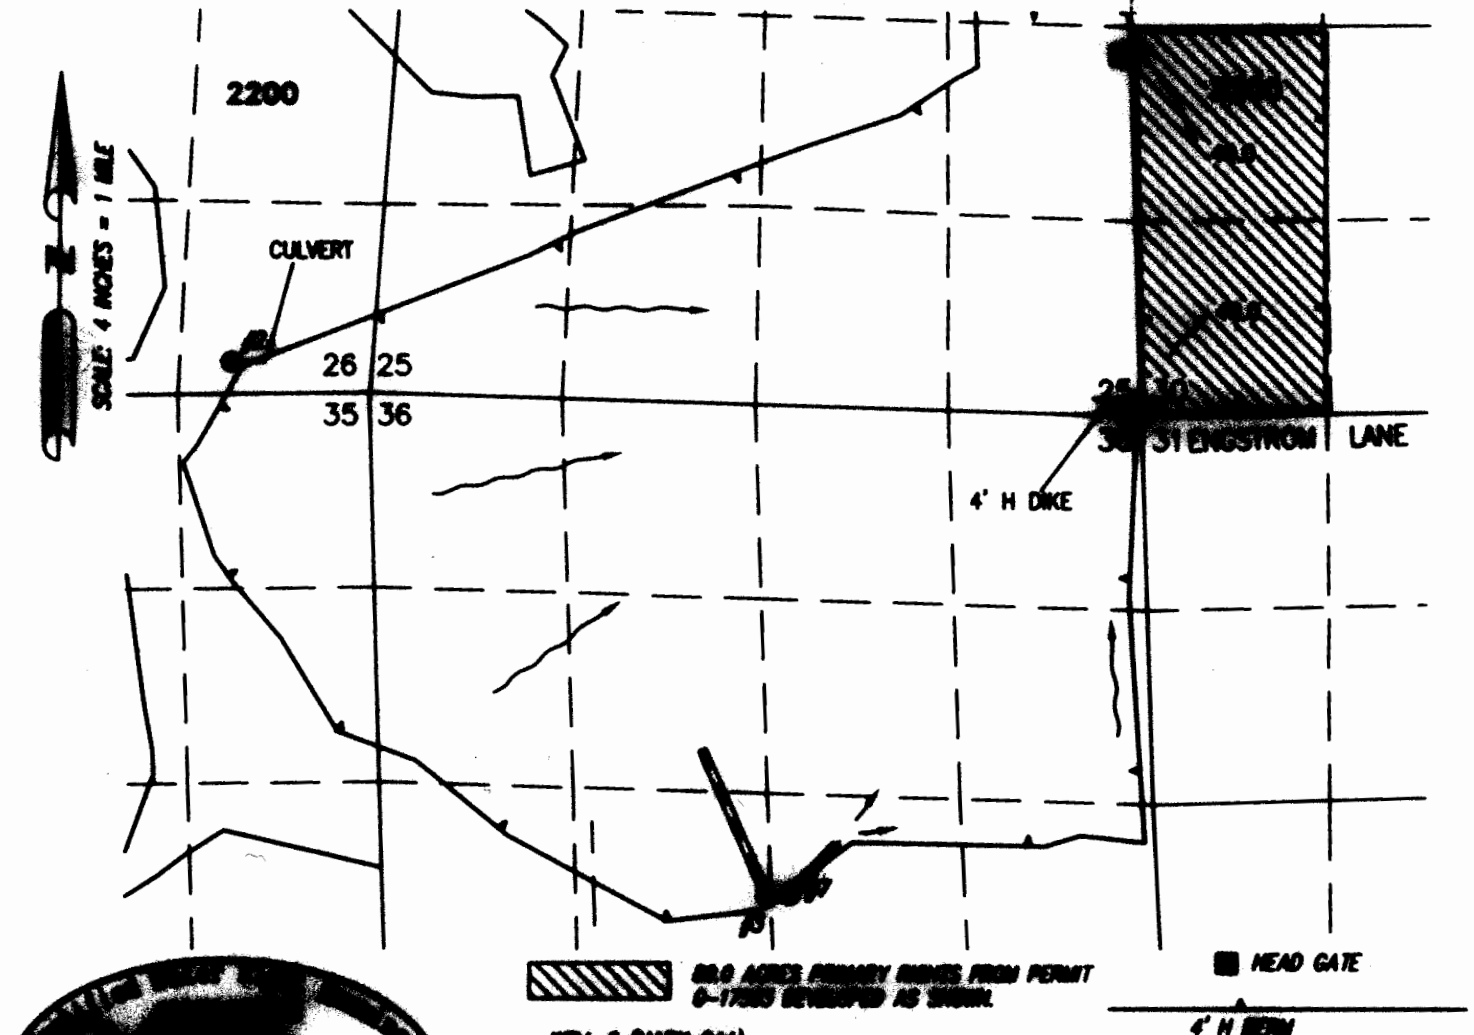

RENEWAL DATE: 12/31/2020

THIS MAP IS FOR THE PURPOSE OF LOCATING A
WATER RIGHT ONLY AND HAS NO INTENT TO
PROVIDE LEGAL BOUNDARIES OR THE LOCATION
OF PROPERTY LINES.



G-17549 DEVELOPED AS SHOWN.

HEAD GATE

4' H BERM

- WELL 2 (DRAIN BASIN)
● LOCATED IN THE SE 1/4 SE 1/4 SECTION 26, T24S R30E, N4M AND 220 FEET
NORTH AND 4350 FEET EAST FROM THE SW CORNER OF SAID SECTION.
FLOW METER IS LOCATED 11' SE FROM WELL.
- WELL 1 (DRAIN BASIN)
● LOCATED IN THE NE 1/4 SW 1/4 SECTION 36, T24S R30E, N4M AND 1835 FEET
NORTH AND 3800 FEET EAST FROM THE SW CORNER OF SAID SECTION.
FLOW METER IS LOCATED 5' NW FROM WELL.
- WELL 7 (DRAIN BASIN)
● LOCATED IN THE NE 1/4 SW 1/4 SECTION 36, T24S R30E, N4M AND 1845 FEET
NORTH AND 3785 FEET EAST FROM THE SW CORNER OF SAID SECTION.
FLOW METER IS LOCATED 6' E FROM WELL.

PREPARED FOR:

MIKE PEILA
P.O. BOX 537
HINES, OR 97738

PREPARED BY:



ALL POINTS ENGINEERING AND SURVEYING, INC.
P.O. BOX 767
TERREBONNE, OR 97760
(541) 548-5833
www.APEandS.com