T.3S. R.1E. Sec. 24 & 25, W.M.

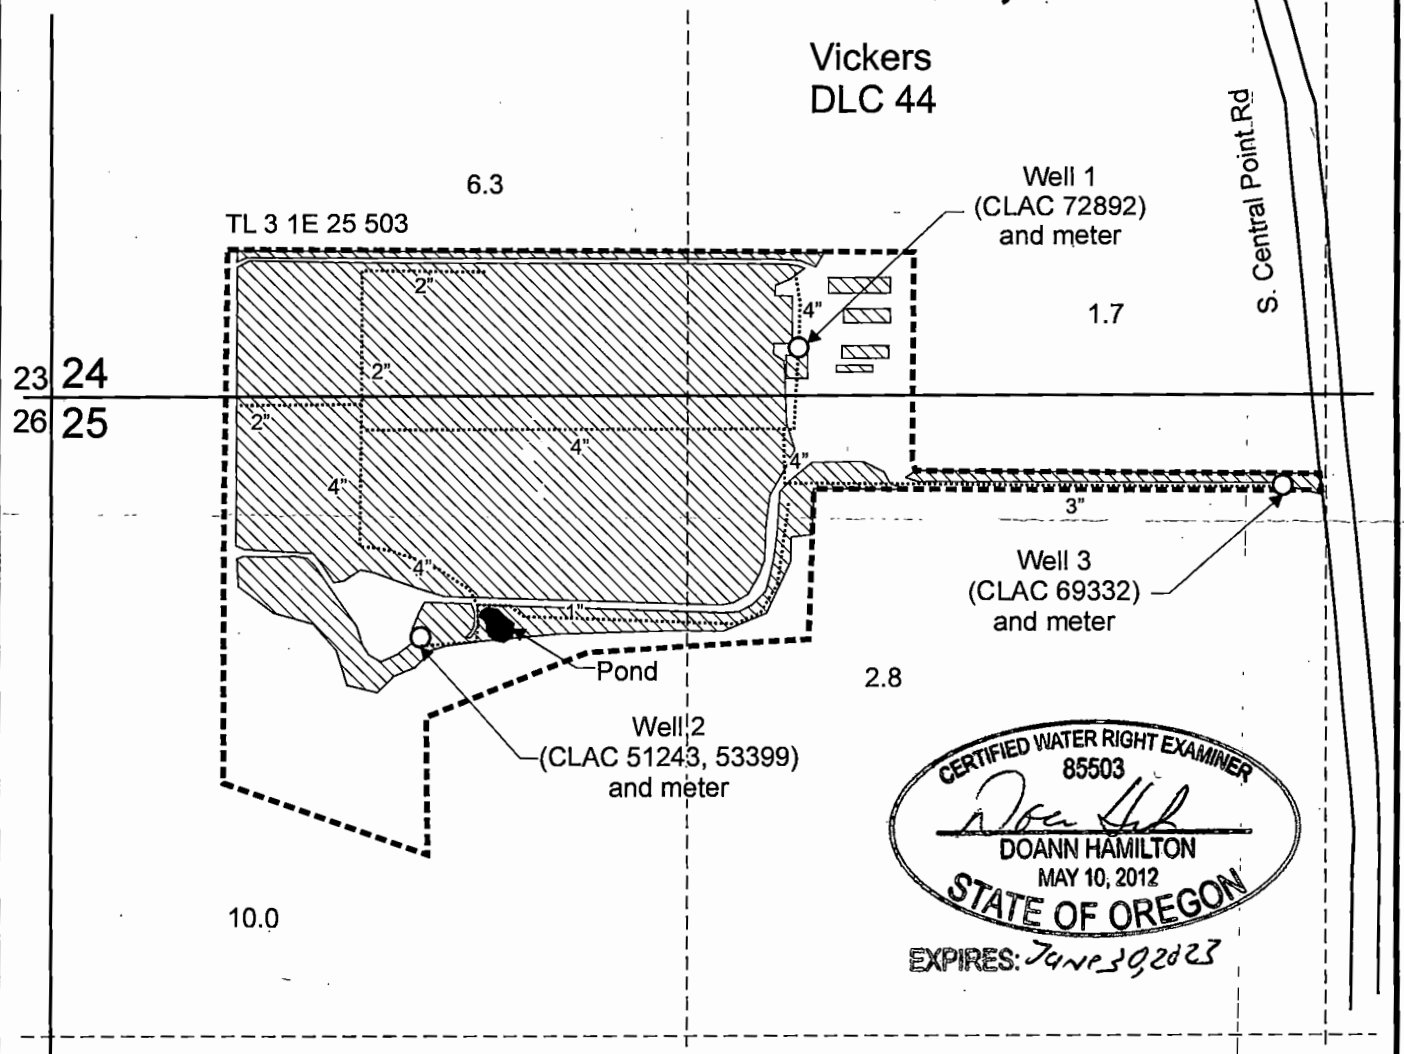

CERTIFIED WATER RIGHT EXAMINER
85503
DOANN HAMILTON
MAY 10, 2012
STATE OF OREGON
EXPIRES: June 30, 2023

Well 1 (CLAC 72892) is located 100 feet north and 1,550 feet east from the NW corner, Section 25.

Well 2 (CLAC 51243, 53399) is located 500 feet south and 765 feet east from the NW corner, Section 25.

Well 3 (CLAC 69332) is located 190 feet south and 2,550 feet east from the NW corner, Section 25.

Area (20.8 Acres) irrigated under Application G-18185, Permit G-17675.

Tax lot boundary

Irrigation mainline

RECEIVED
JUL 12 2021
OWRD

N

Scale: 1" = 400'

0 400 800 Feet

This map was prepared for the purpose of identifying the location of a water right only and is not intended to provide legal dimensions or location of property ownership lines.

CollinsG-1815COBUMap.cdr

Pacific Hydro-Geology Inc.

Claim of Beneficial Use Map
Application G-18185, Permit G-17675

Craig and Cheryl Collins
T.3S. R.1E. Sec. 24 & 25, W.M.

07/2021