


FINAL PROOF MAP FOR CHANGE IN POA FOR T-12280
LOT 1 REDTAIL MEADOWS SUBDIVISION FOR SCALE
C. 91154 LOCATED IN SE1/4 SW1/4 OF 1" = 200'
SECTION 12 AND IN NE1/4 NW1/4 OF
SECTION 13, T.16S., R.16E., W.M., CROOK JUNE 4, 2020
COUNTY, OREGON W.O. 20-4626

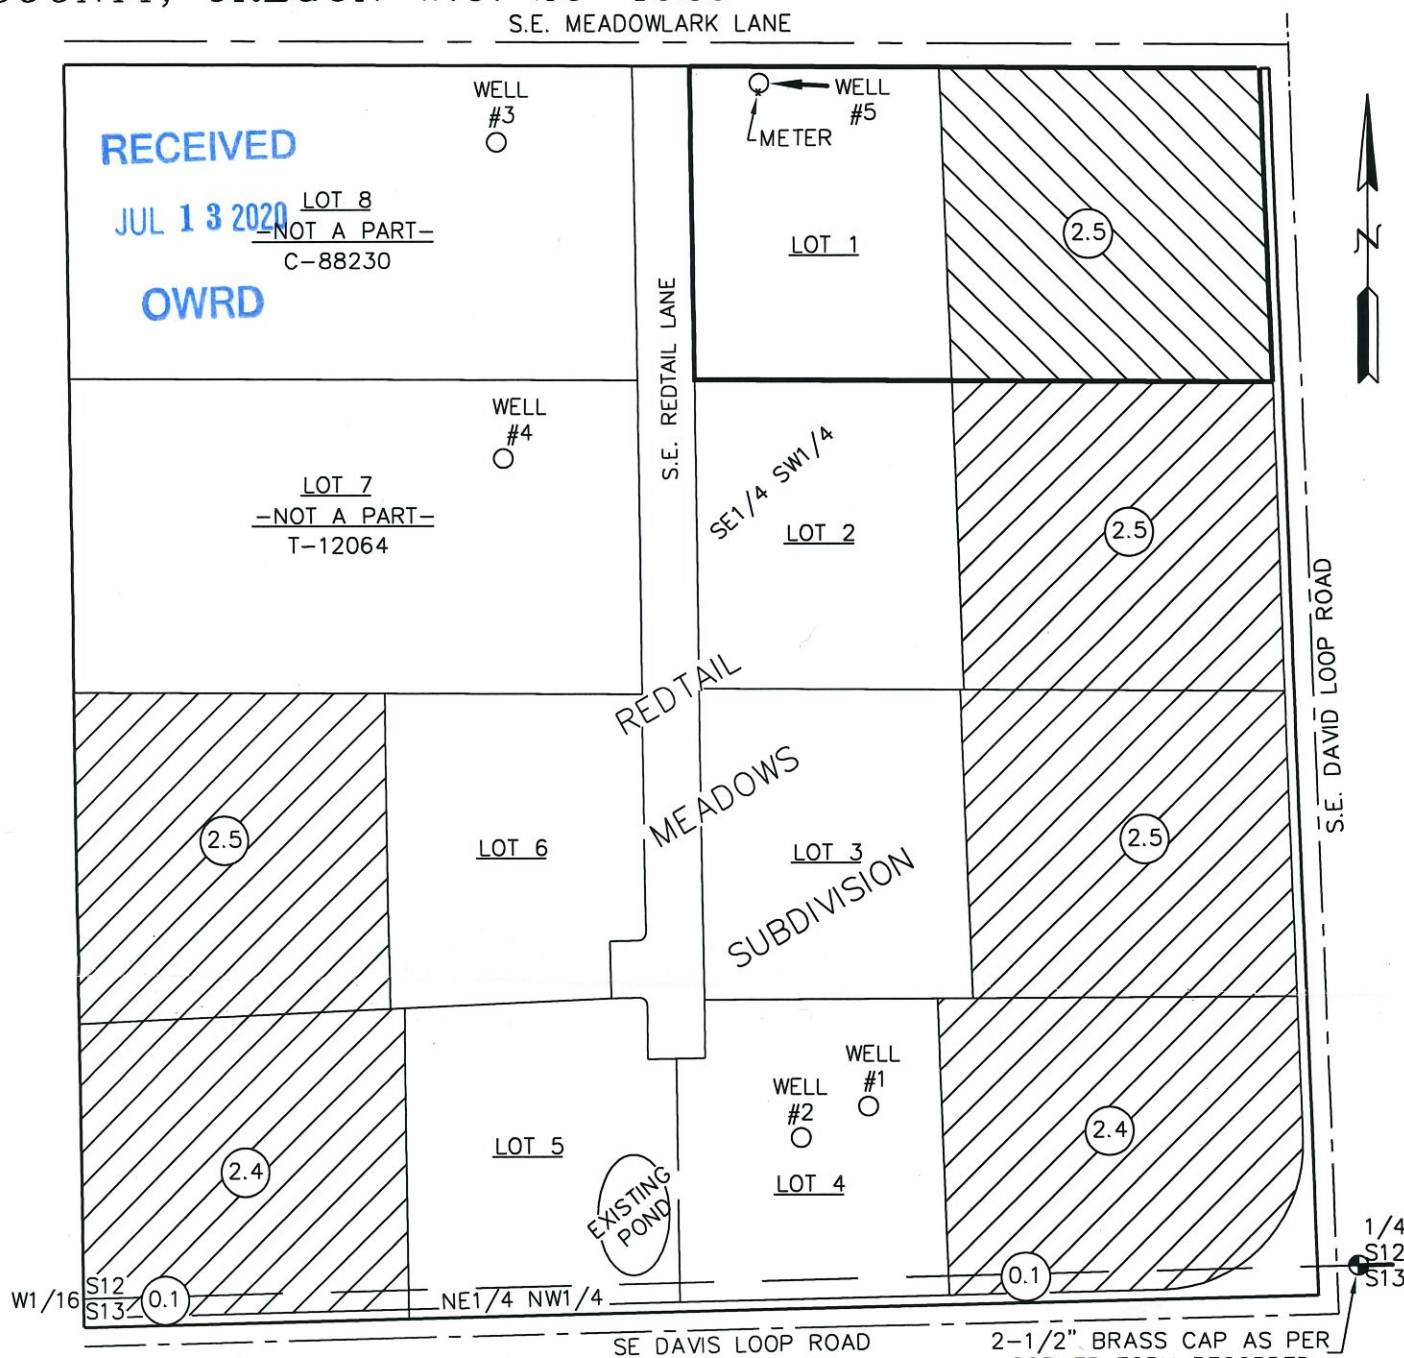

PREPARED FOR PREPARED BY

MARY E. BOWLES 12174 SE REDTAIL LN. PRINEVILLE, OR 97754 (559)753-0618
DAVID B. ARMSTRONG, CWRE 2781 NE SUNSET VIEW LN. PRINEVILLE, OR 97754 (541)728-8266

EXISTING WELL LOCATIONS - CERTIFICATE 91154
WELL #1 - LOCATED IN SE1/4 SW1/4 SECTION 12, T.16S., R.16E., W.M., 178 FT. NORTH AND 510 FT. WEST OF THE S1/4 CORNER SECTION 12.
WELL #2 - LOCATED IN SE1/4 SW1/4 SECTION 12, T.16S., R.16E., W.M., 147 FT. NORTH AND 581 FT. WEST OF THE S1/4 CORNER SECTION 12.
CHANGE IN POINT OF APPROPRIATION - LOCATION
WELL #5 - LOCATED IN SE1/4 SW1/4 SECTION 12, T.16S., R.16E., W.M., 1230 FT. NORTH AND 622 FT. WEST OF THE S1/4 CORNER SECTION 12.
LATITUDE: 44.1929481796° NORTH
LONGITUDE: 120.76148562469° WEST
WGS84

WATER RIGHTS

PRIMARY - C-91154 - NO CHANGE
T.16S., R.16E., W.M. TOTAL - 12.5 AC.


MAP 16-16-12C	PLAT	SECTION 12	SECTION 13
TAX LOT	LOT	SE1/4 SW1/4	NE1/4 NW1/4
701	2	2.5 AC.	-
702	3	2.5 AC.	-
703	4	2.4 AC.	0.1 AC.
704	5	2.4 AC.	0.1 AC.
705	6	2.5 AC.	-
TOTAL		12.3 AC.	0.2 AC.

PRIMARY - T-12280 - CHANGE POA
T.16S., R.16E., W.M. TOTAL - 2.5 AC.

MAP 16-16-12C	PLAT	SECTION 12	SECTION 13
TAX LOT	LOT	SE1/4 SW1/4	NE1/4 NW1/4
700	1	2.5 AC.	-

MAP NOTE

THE PREPARATION OF THIS MAP IS FOR THE PURPOSE OF IDENTIFYING THE LOCATION OF THE WATER RIGHT ONLY AND HAS NO INTENT TO PROVIDE DIMENSIONS OR LOCATIONS OF PROPERTY OWNERSHIP LINES.

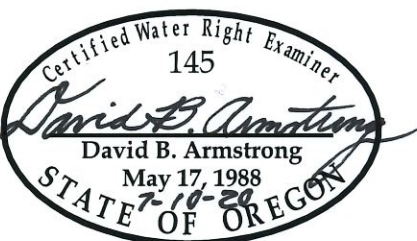

Renews December 31, 2021

DRG. NO. 10-3985.DWG
W.O. 20-4626