




1" = 400'

NOTE: THIS MAP IS NOT INTENDED TO PROVIDE LEGAL
DIMENSIONS OR LOCATIONS OF PROPERTY OWNERSHIP LINES.

RECEIVED BY OWRD

SEP 25 2012

SALEM, OR

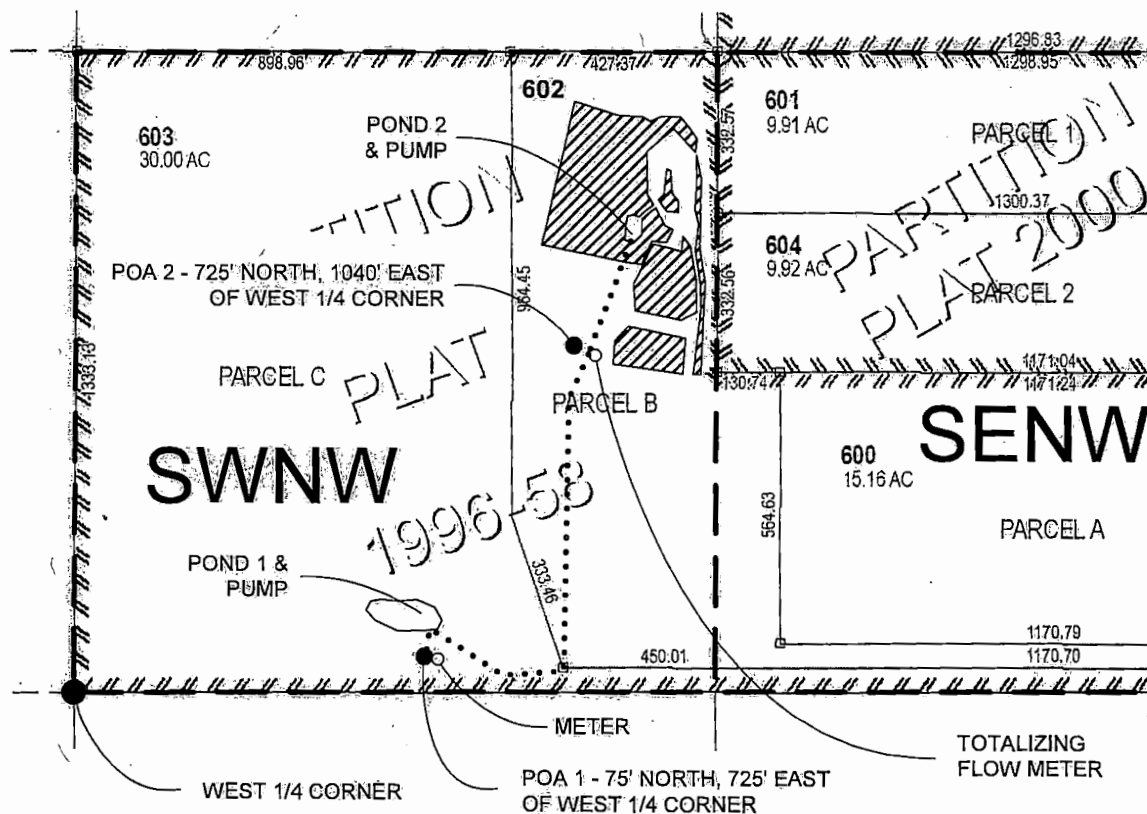

DESCHUTES COUNTY, OREGON

TOWNSHIP 18 SOUTH
RANGE 13 EAST,
WILLAMETTE MERIDIAN


SECTION 8 (TAX LOT 602)

SW 1/4 NW 1/4 2.2 IRRIGATED ACRES

TRANSFER T-9529

APPLICATION G-14284

PERMIT G-13127

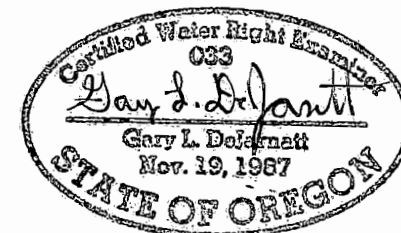

RENEWAL DATE: 12-31-2013



POU - IRRIGATION



QUARTER QUARTER
BOUNDARY



BURIED PIPELINE

TITLE

CLAIM OF BENEFICIAL USE MAP for
JOHN TRUE

WATER RIGHT SERVICES, LLC

P.O. BOX 1830, BEND OR 97709

WWW.OREGONWATER.US

(541) 389-2837 CCB# 19712

DATE

SEPT 6, 2012

JOHNSHORT@USA.COM

JOB#

12043