


T.12 S., R. 8 W., W.M.

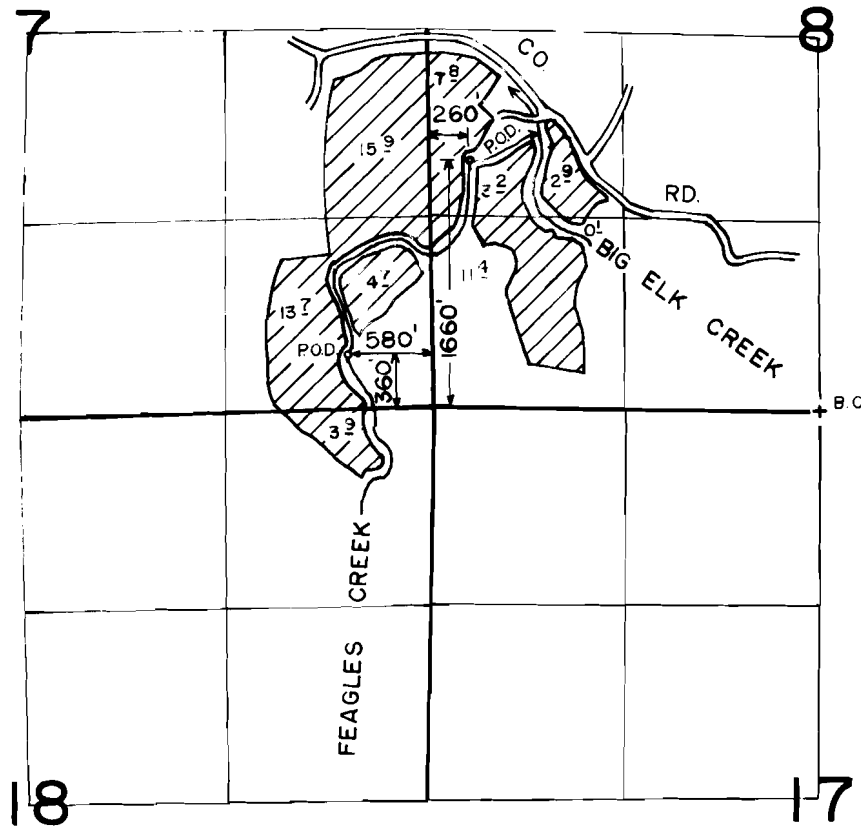

1" = 1320'

FINAL PROOF SURVEY
UNDER

Application No. 54217 Permit No. 40617
IN NAME OF

WINSTON GRANT

Surveyed SEPT. 20 1983, by L. TOLL
NOV. 13 1989, T.M. WARREN

8-29-90 DSM
41041-372-62