

Document Path: Y:\0895 Ariola Cranberry\Source Figures\001 Hoffer Lane Farm\COBU Permit G12920.mxd, abarry


LEGEND

- Point of Appropriation (POA)
- Pump House for Sump
- ▨ Place of Use (POU)
- Tax Lot
- ~ Watercourse
- ☾ Waterbody

Mainline

- 5"
- 6"

CERTIFIED WATER RIGHTS EXAMINER STAMP

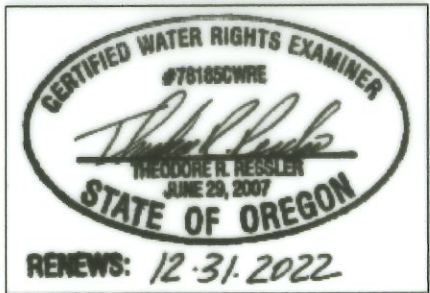

LOCATION DESCRIPTION

Well 2 (COOS 51155, L-25037)
 Located 800 feet South and 170 feet East from N1/4 corner of Section 25, Township 29 South, Range 15 West (WM).

Well 3 (COOS 51155, L-25036)
 Located 1650 feet South and 210 feet East from N1/4 corner of Section 25, Township 29 South, Range 15 West (WM)

Sump 1
 Located 2100 feet South and 105 feet East from N1/4 corner of Section 25, Township 29 South, Range 15 West (WM)

Sump 3
 Located 410 feet South and 110 feet East from N1/4 corner of Section 25, Township 29 South, Range 15 West (WM)

Claim of Beneficial Use Map
Permit G-12920 (Application G-13530)
A Water Right held USDA Farm Service Agency
 Township 29 South, Range 15 West (W.M.)
 Coos County

DISCLAIMER

This map was prepared for the purpose of identifying the location of a water right only and it is not intended to provide legal dimensions or location of property ownership lines.

Date: October 13, 2021
 Data Sources: BLM, ESRI, OWRD, USGS, Coos Co.

