


RECEIVED

DEC 17 2021

OWRD

CLAIM OF BENEFICIAL USE MAP
APPLICATION S-85219 PERMIT S-54027
FOR
RUSSELL AND NORA JUNCAL
1965 HILT ROAD
HORN BROOK, CA 96044
SITUATED IN
DLC NO. 37 & 38
TOWNSHIP 41 SOUTH, RANGE 2 EAST, WILLAMETTE MERIDIAN
JACKSON COUNTY, OREGON
AND
FRACTIONAL SECTION 14
TOWNSHIP 48 NORTH, RANGE 7 WEST, MT. DIABLO MERIDIAN
SISKIYOU COUNTY, CALIFORNIA

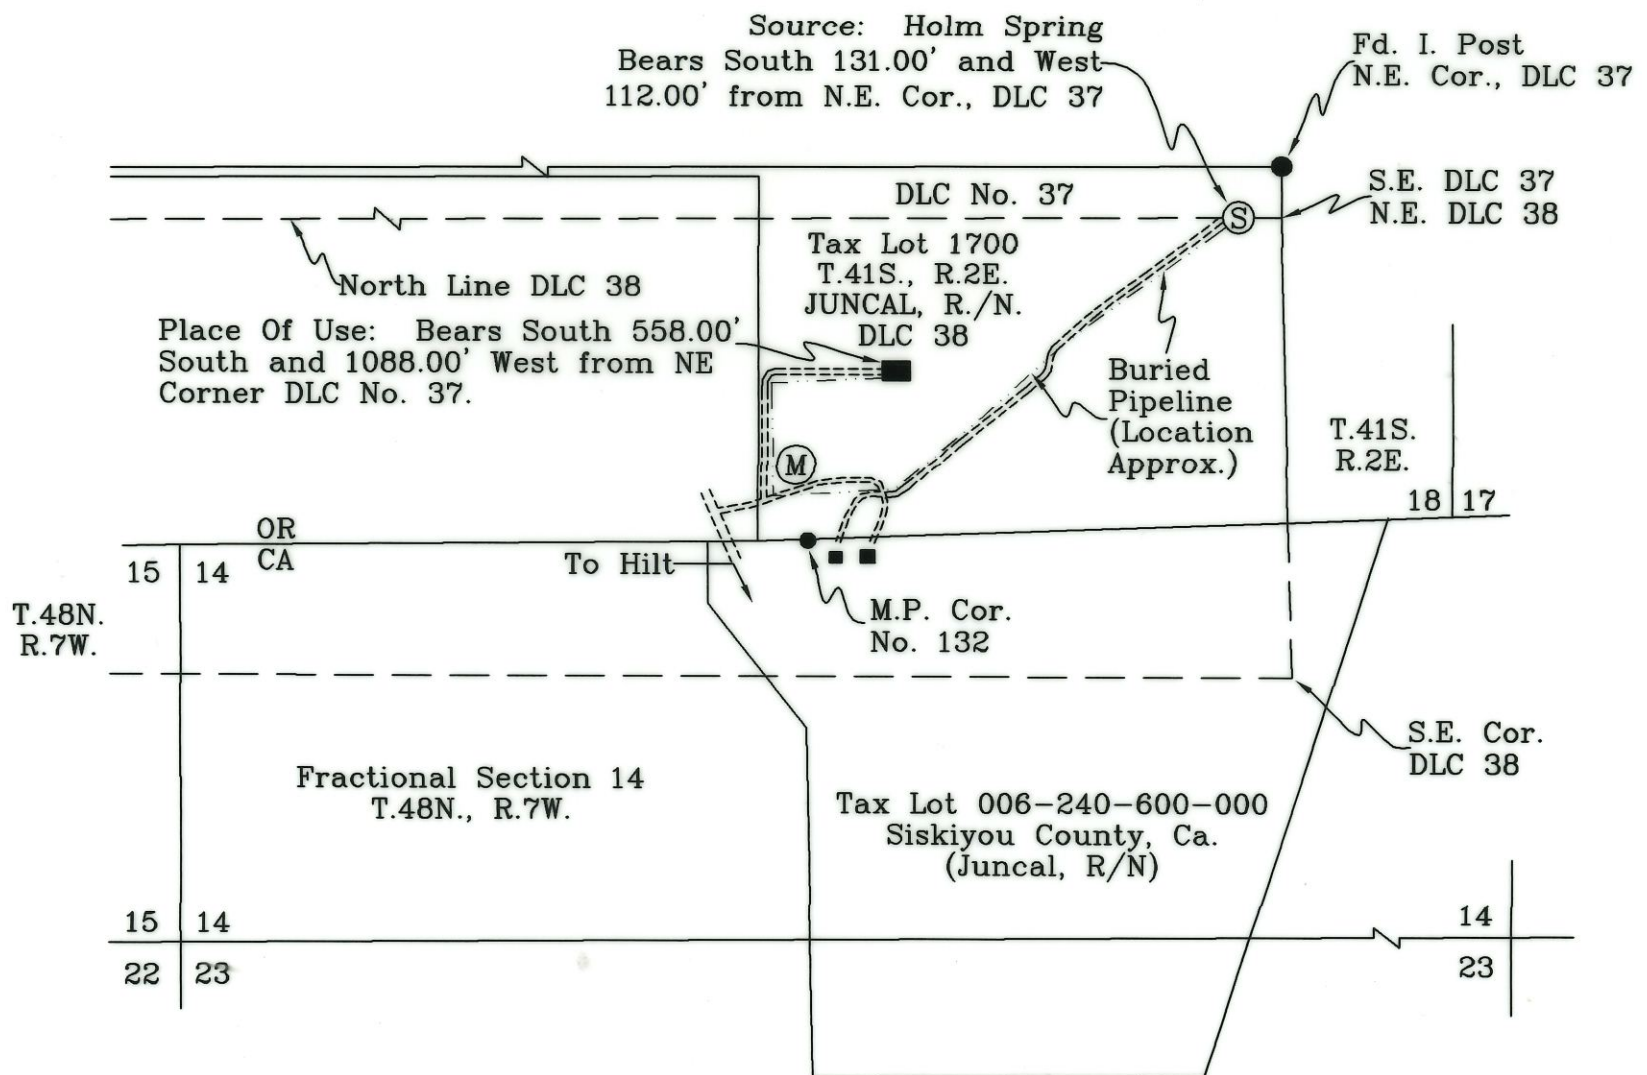

Scale: 1"=500'
December 3, 2021

LEGEND

- Found Survey Monument
- Denotes Structure/Building-Place Of Use
- Denotes Driveway
- - - - Denotes Buried Pipeline
- (M) Denotes Flow Meter
- (S) Denotes Spring

This map was prepared for the purpose of
identifying the location of a water right only
and is not intended to provide legal dimen-
sions or location of property ownership.

COBU MAP #
1322 A-8



Renews: 12/31/23

HAROLD L. CENTER
2604 David Lane
Medford, OR. 97504
Phone 541-535-6108
Oregon Certificate No. 152