
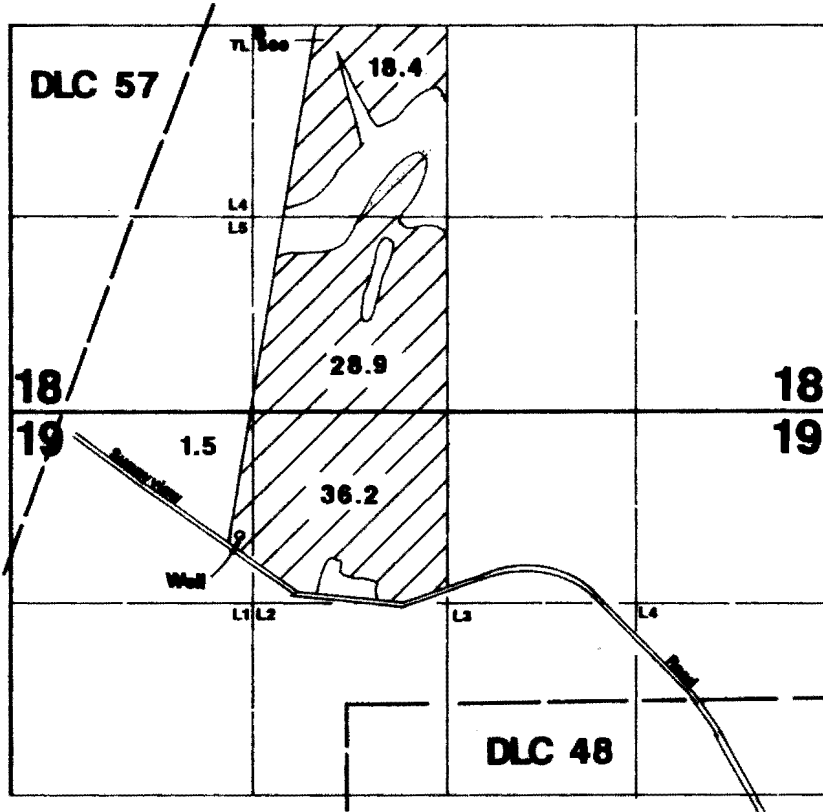


# T.7S., R.1.W, W.M

 

Well is located 1175'N & 720'W from the NW corner of DLC 48.

## Final Proof Survey

In Name Of

# Stan A. & Greg L. Herr

Application #: G-14638

Permit #: G-13440

Surveyed on November 30, 2002 by JM Schuette

This Map Was Prepared For The Purpose Of Identifying The Location Of A Water Right Only And Is Not Intended To Provide Legal Dimensions Or Location Of Property Ownership Lines.

