


Claim of Beneficial Use Map Transfer T-13353 Avion Water Company, Inc Point of Appropriation Map


Deschutes County, Oregon
Township 18 South, Range 12 East (W.M.)

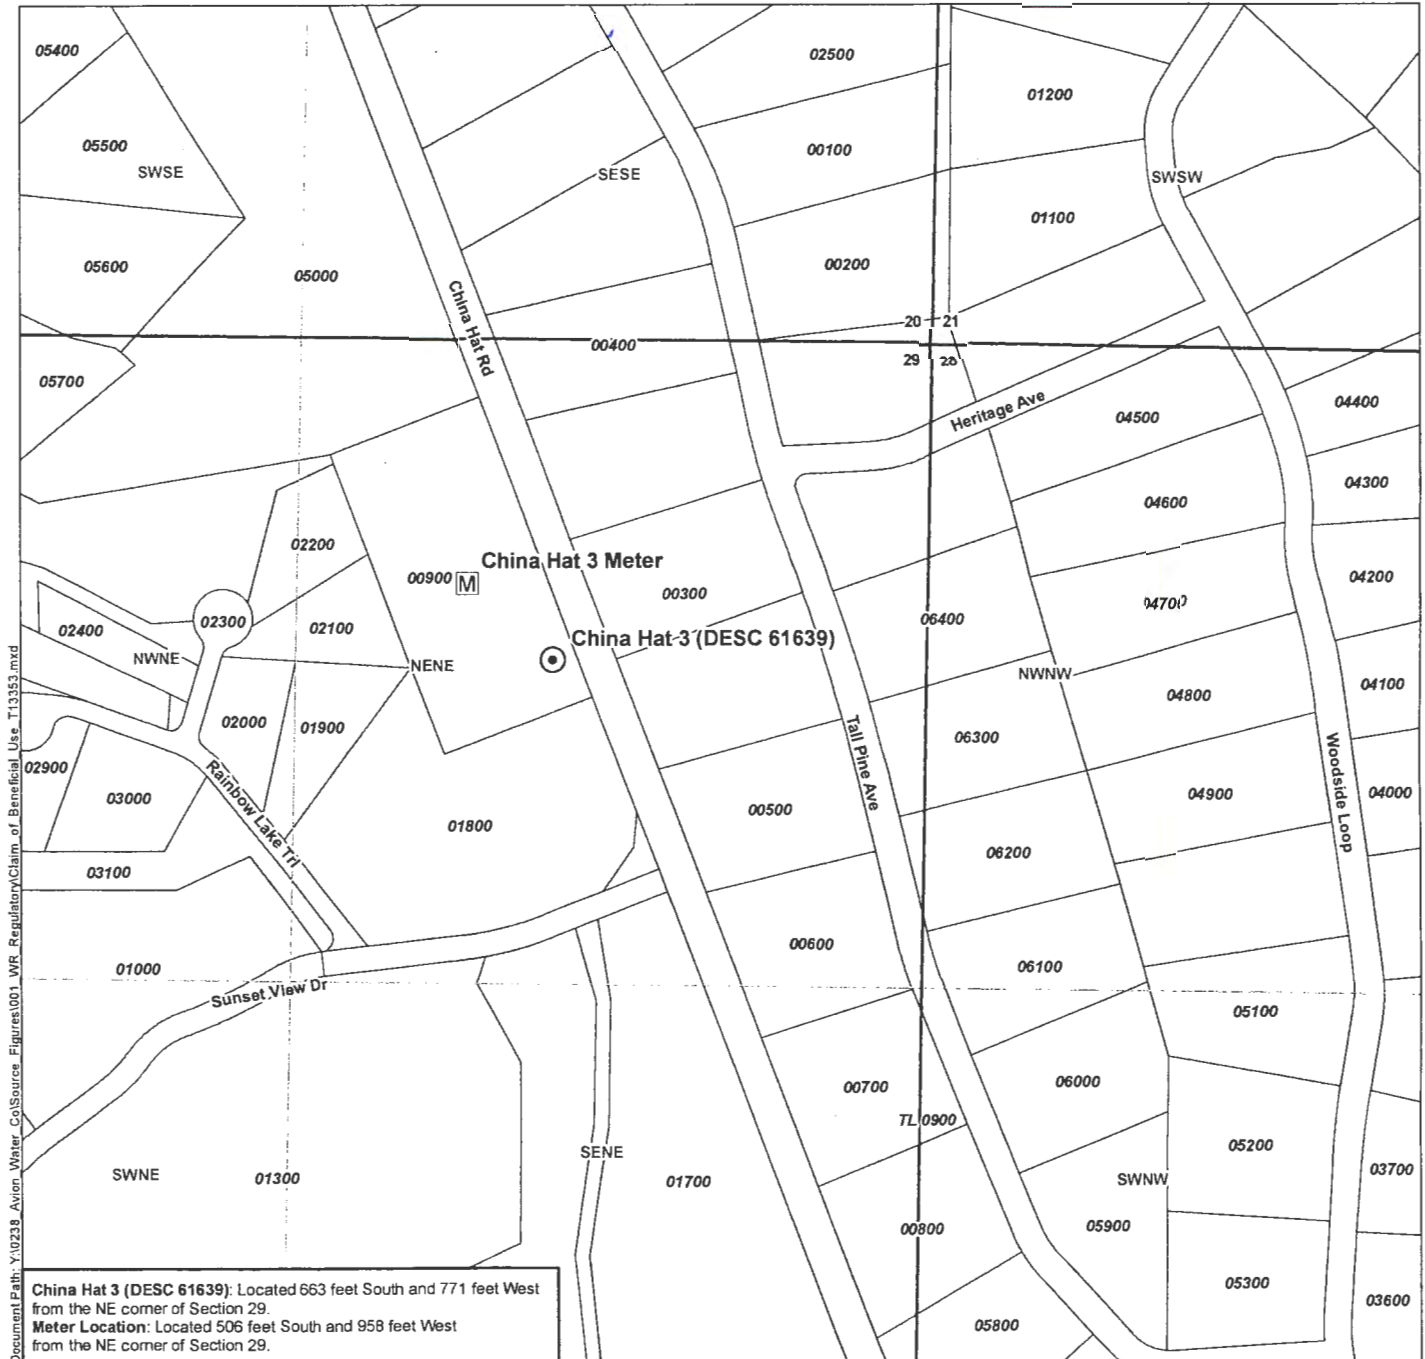

Document Path: Y:\0239_Avion_Water_Co\Source_Figures\001_WR_Regulatory\Claim_of_Beneficial_Use_T13353.mxd

China Hat 3 (DESC 61639): Located 663 feet South and 771 feet West from the NE corner of Section 29.
Meter Location: Located 506 feet South and 958 feet West from the NE corner of Section 29.

- LEGEND**
- Authorized Point of Appropriation (POA)
 - Meter Location
 - Government Lot (GL)
 - All Other Features**
 - Tax Lot
 - Major Road

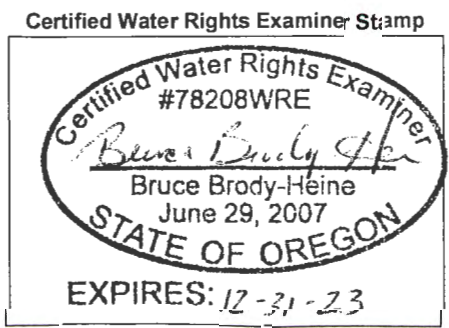

DISCLAIMER
 This map was prepared for the purpose of identifying the location of a water right only and it is not intended to provide legal dimensions or location of property ownership lines.

RECEIVED

MAP NOTES
 Date: February 8, 2022
 Data Sources: BLM, USGS, ESRI

OWRD