

Document Path Y:\0182\_EWFBSource\_Figures\020\_Access\_WWP\_Storage\_Water\COBU\_T12120\_Dorena.mxd Albany

**LEGEND**

- Authorized Place of Use (POU) Where Character of Use Was Changed
- Location of Dam
- Railroad
- Major Road
- Watercourse
- Waterbody

**Claim of Beneficial Use**  
**Transfer T-12120 (Dorena Reservoir)**  
**A Water Right in the Name of US Bureau of**  
**Reclamation**  
 Lane County  
 Township 20, 21 South, Range 2 West (W.M.)

**CERTIFIED WATER RIGHTS EXAMINER STAMP**



RECEIVED

FEB 02 2022

OWRD

**DISCLAIMER**  
 This map was prepared for the purpose of identifying the location of a water right only and it is not intended to provide legal dimensions or location of property ownership lines.


Date: January 19, 2022  
 Data Sources: BLM, ESRI, OWRD, USGS



0 2,000 4,000  
 1 inch = 4,000 feet





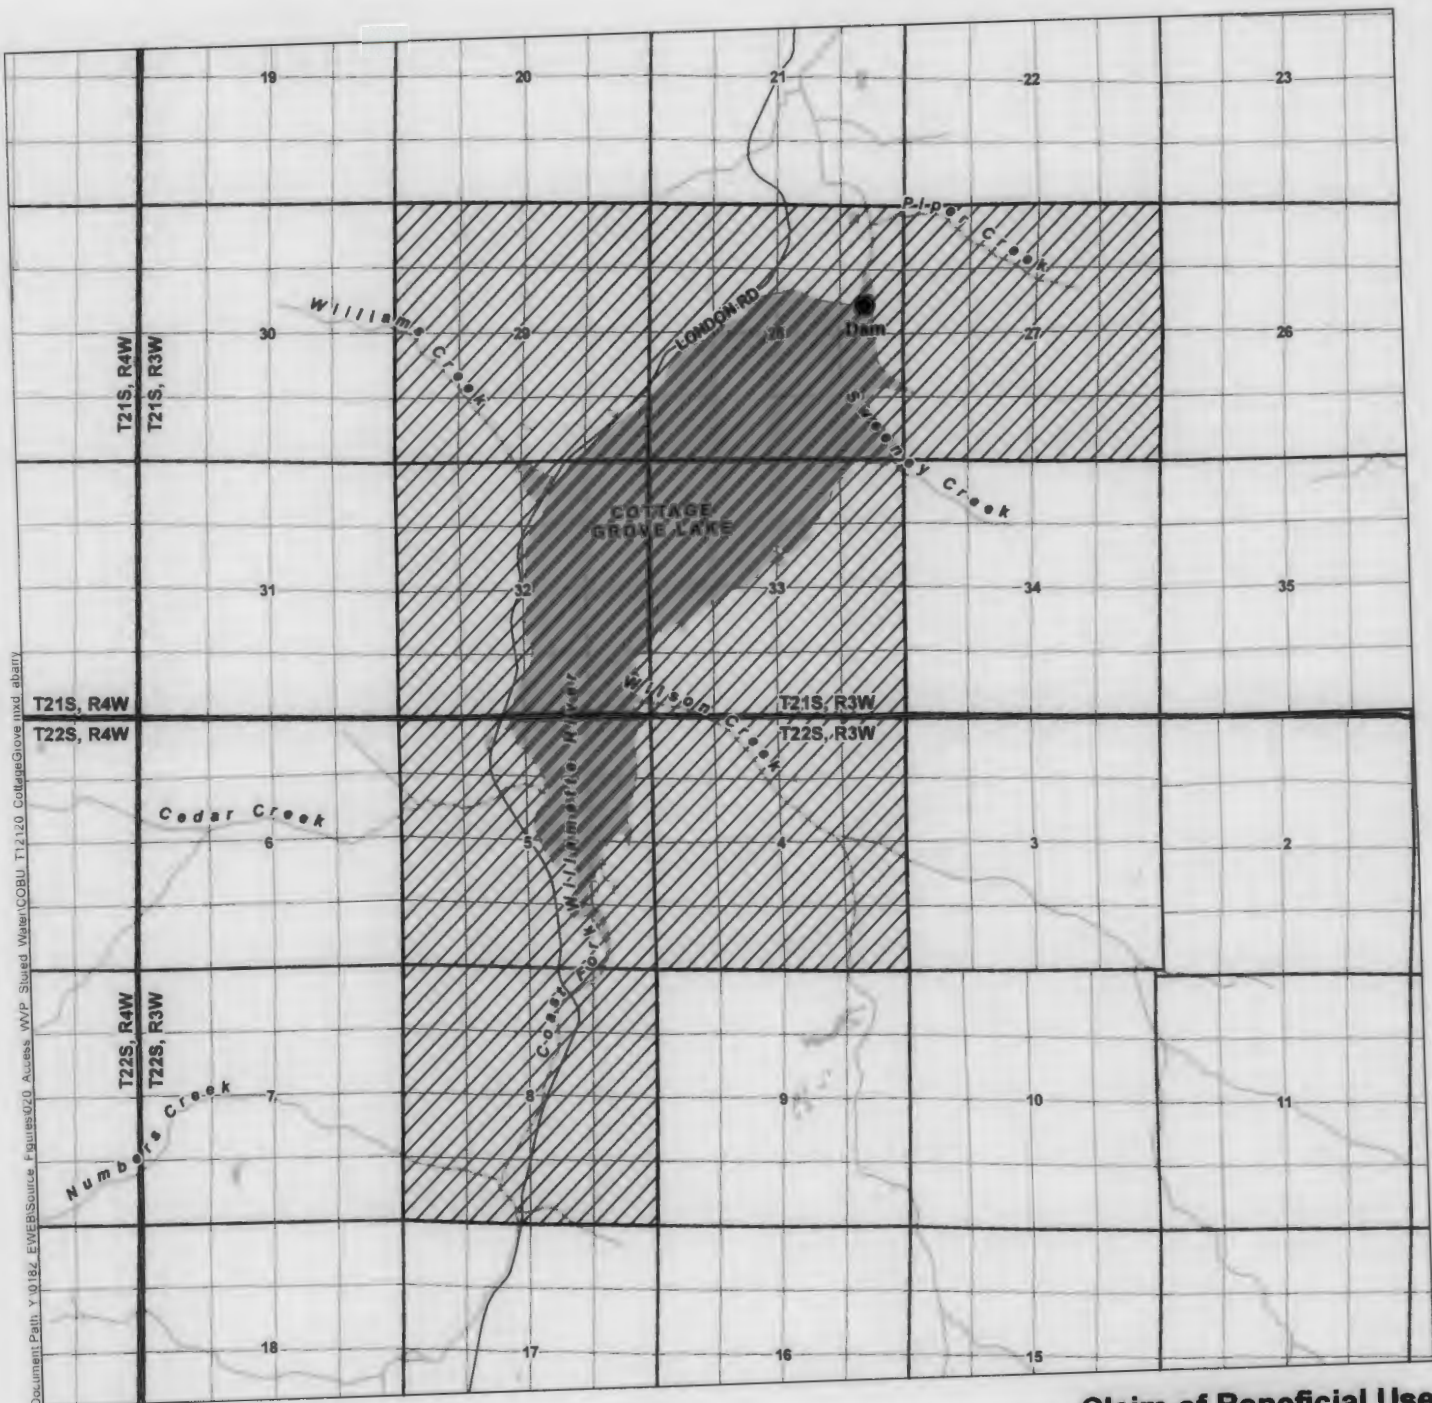

Document Path: Y:\0184\_EWFB\Source\_Figures\020\_Access\_WWP\_Storage\Water\COBLU\_T12120\_CottageGrove.mxd, abatt

- LEGEND**
- Authorized Place of Use (POU) Where Character of Use Was Changed
  - Location of Dam
  - Major Road
  - Watercourse
  - Waterbody

**Claim of Beneficial Use**  
**Transfer T-12120 (Cottage Grove Reservoir)**  
**A Water Right in the Name of US Bureau of**  
**Reclamation**  
 Lane County  
 Township 21, 22 South, Range 3 West (W.M.)

RECEIVED

FEB 02 2022

OWRD

**CERTIFIED WATER RIGHTS EXAMINER STAMP**

**CERTIFIED WATER RIGHTS EXAMINER**  
 #76185CWRE  
  
**THEODORE H. NESSLER**  
 JUNE 29, 2007  
**STATE OF OREGON**

**RENEWS: 12-31-2022**

**DISCLAIMER**  
 This map was prepared for the purpose of identifying the location of a water right only and it is not intended to provide legal dimensions or location of property ownership lines.

Date: January 19, 2022  
 Data Sources: BLM, ESRI, OWRD, USGS

