


T.35S., R.2E., W.M.

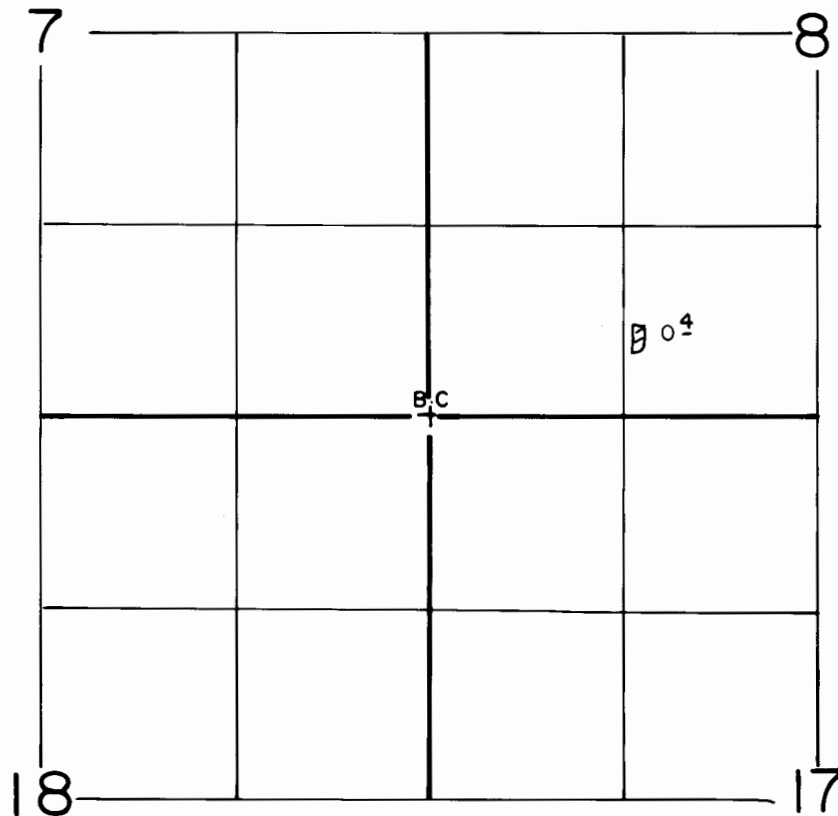

SCALE: 1"=1320'

FINAL PROOF SURVEY
UNDER


TRANSFER NO. 3054

Application No. Permit No.
IN NAME OF

PRESTON C. & RENEE ROSENBAUM

Surveyed AUG. 21.. 1989., by B.S. JAMES.....


T.35S. R.2E.W.M.

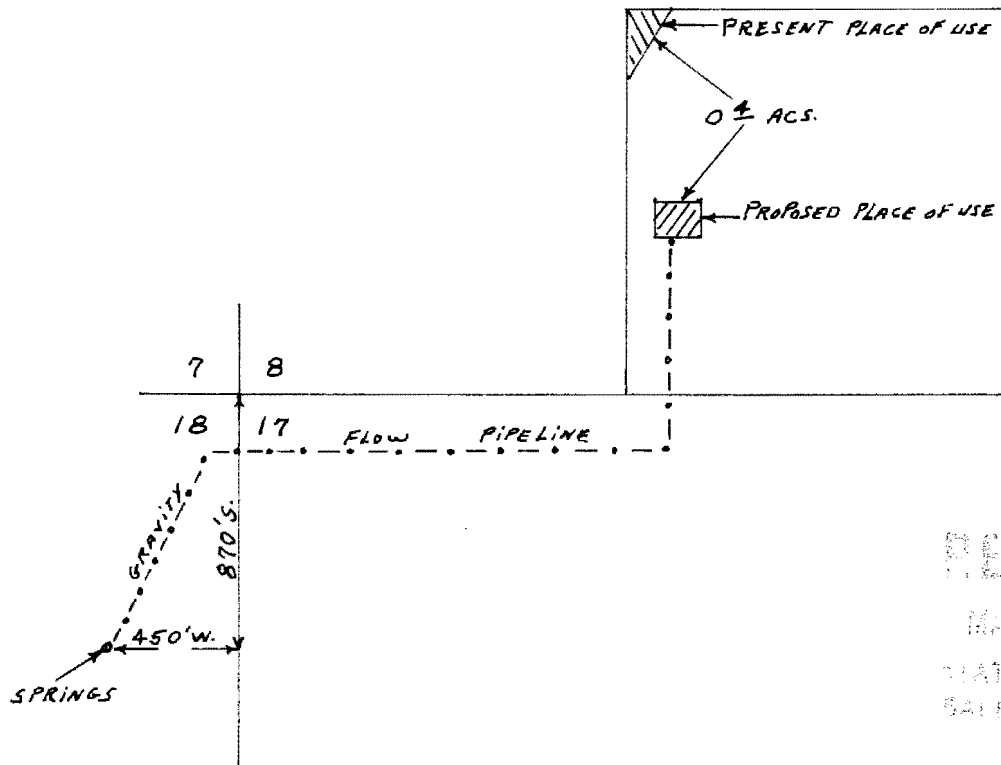

RECEIVED
MAY 29 1974
STATE ENGINEER

MAP TO ACCOMPANY APPLICATION OF
FRED J. AND MARTHA L. YOUNGBLOOD
FOR CHANGE IN PLACE OF USE

SCALE 8" = 1 MILE

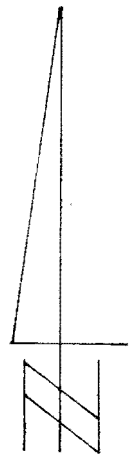

5-21-74

T-3054