

T.4S. R.1W. Section 7, W.M.



Well (MARI 50196) is located 1,045 feet north and 800 feet east from the center corner, Section 7.

 Area (6.5 Acres) irrigated under T-12539, priority 11-28-1966.


----- Tax lot boundary

— • — Donation Land Claim boundary

..... Water main line

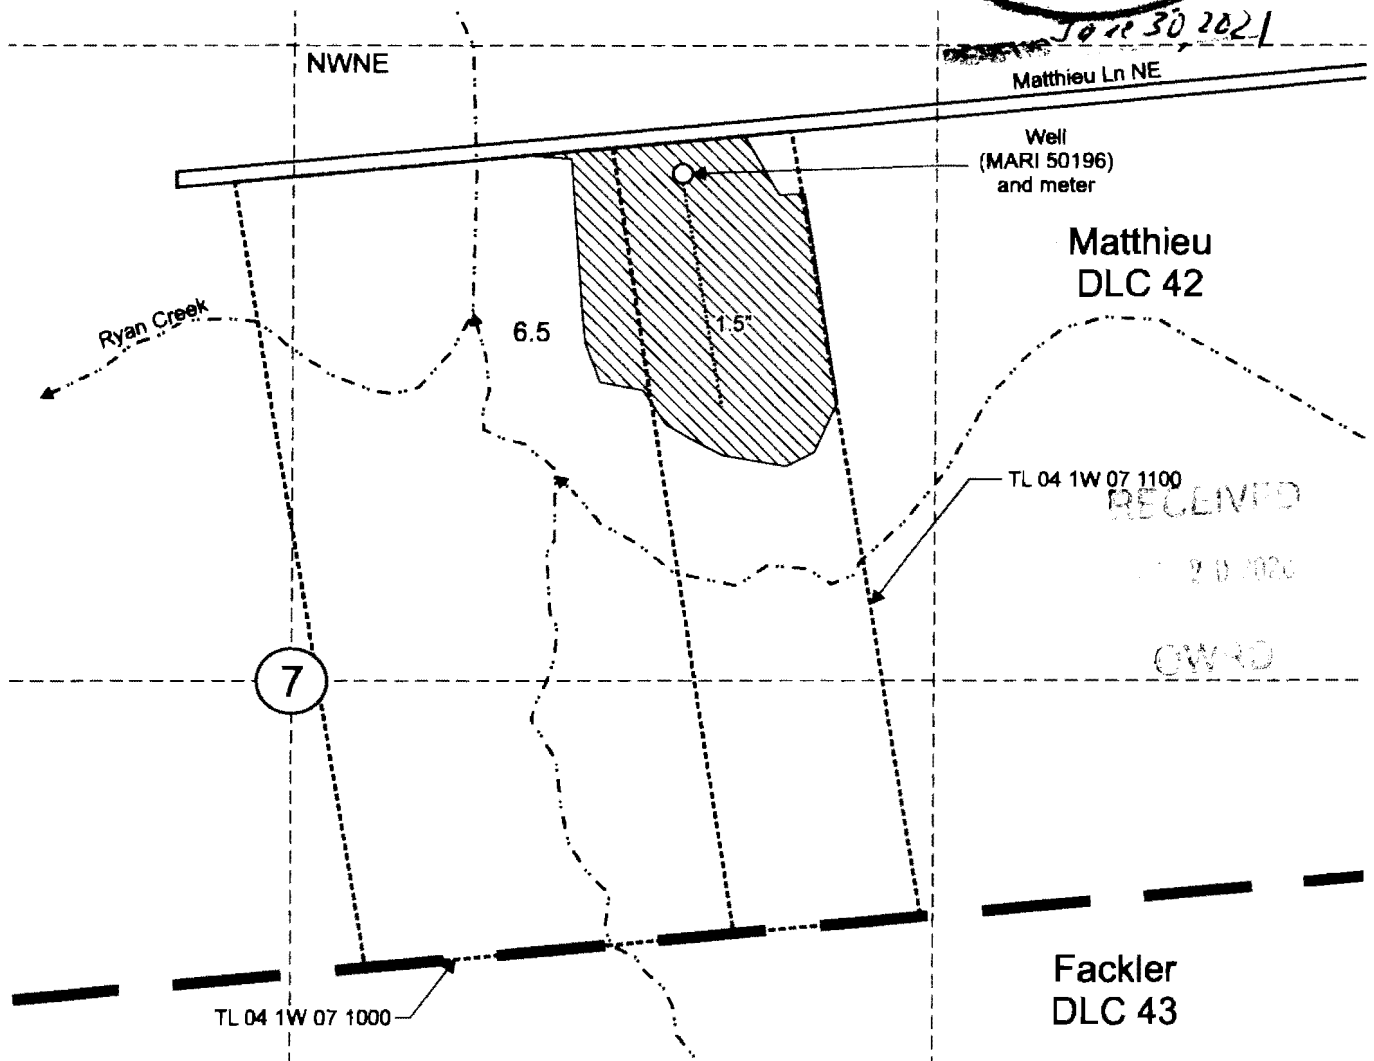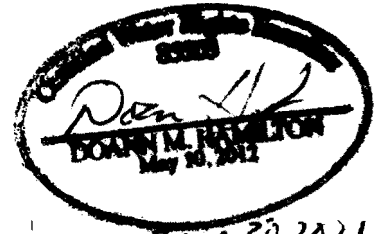

Scale: 1" = 400'

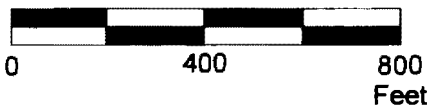

This map was prepared for the purpose of identifying the location of a water right only and is not intended to provide legal dimensions or location of property ownership lines.

Claim of Beneficial Use Map
T-12539

Pacific Hydro-Geology Inc.

Keddie Farms c/o Reg and Lora Keddie
T.4S. R.1W. Section 7, W.M.

07/2020