


CLAIM OF BENEFICIAL USE
 LOTS 4(TL 500), LENART ACRES
 LOCATED IN THE NE 1/4 OF SECTION 22, T.2.S., R6.E., W.M.
 CITY OF SANDY, CLACKAMAS COUNTY, OREGON
 TRANSFER APPLICATION NO. T-13372


RECEIVED

MAY 05 2021

OWRD

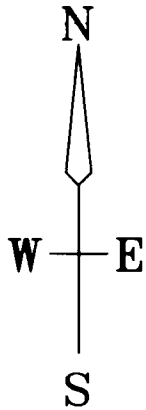

SCALE
 1"=400'

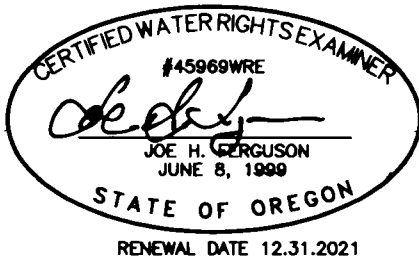

RESERVOIR
 TANK

POD 1


SE 1/4 SE 1/4
 SECTION 15

15 14
 22 23

LOT 5 (.64 Acres)
 PART OF
 TAX LOT 600
 (FROM)
 Priority 9/26/1960

NE 1/4 NE 1/4
 SECTION 22

1 1/4"
 MAINLINE

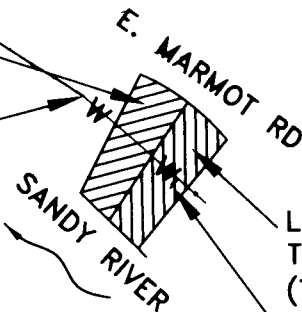

LOT 4 (.68 Acres)
 TAX LOT 500
 (TO)

NEW WATERLINE
 IN PLACE

NOTE: THIS MAP IS NOT INTENDED TO PROVIDE
 LEGAL DIMENSIONS OR LOCATIONS OF PROPERTY
 OWNERSHIP.

LEGEND
 W = EXISTING WATER LINE

CLIENT: ROBIN JACOBS
 59890 E MARMOT RD
 SANDY, OREGON 97055