


DEC 05 2003

SEE MAP 11 26

NOV 04 2003

WATER RESOURCES DEPT
SALEM, OREGON

WATER RESOURCES DEPT
SALEM, OREGON

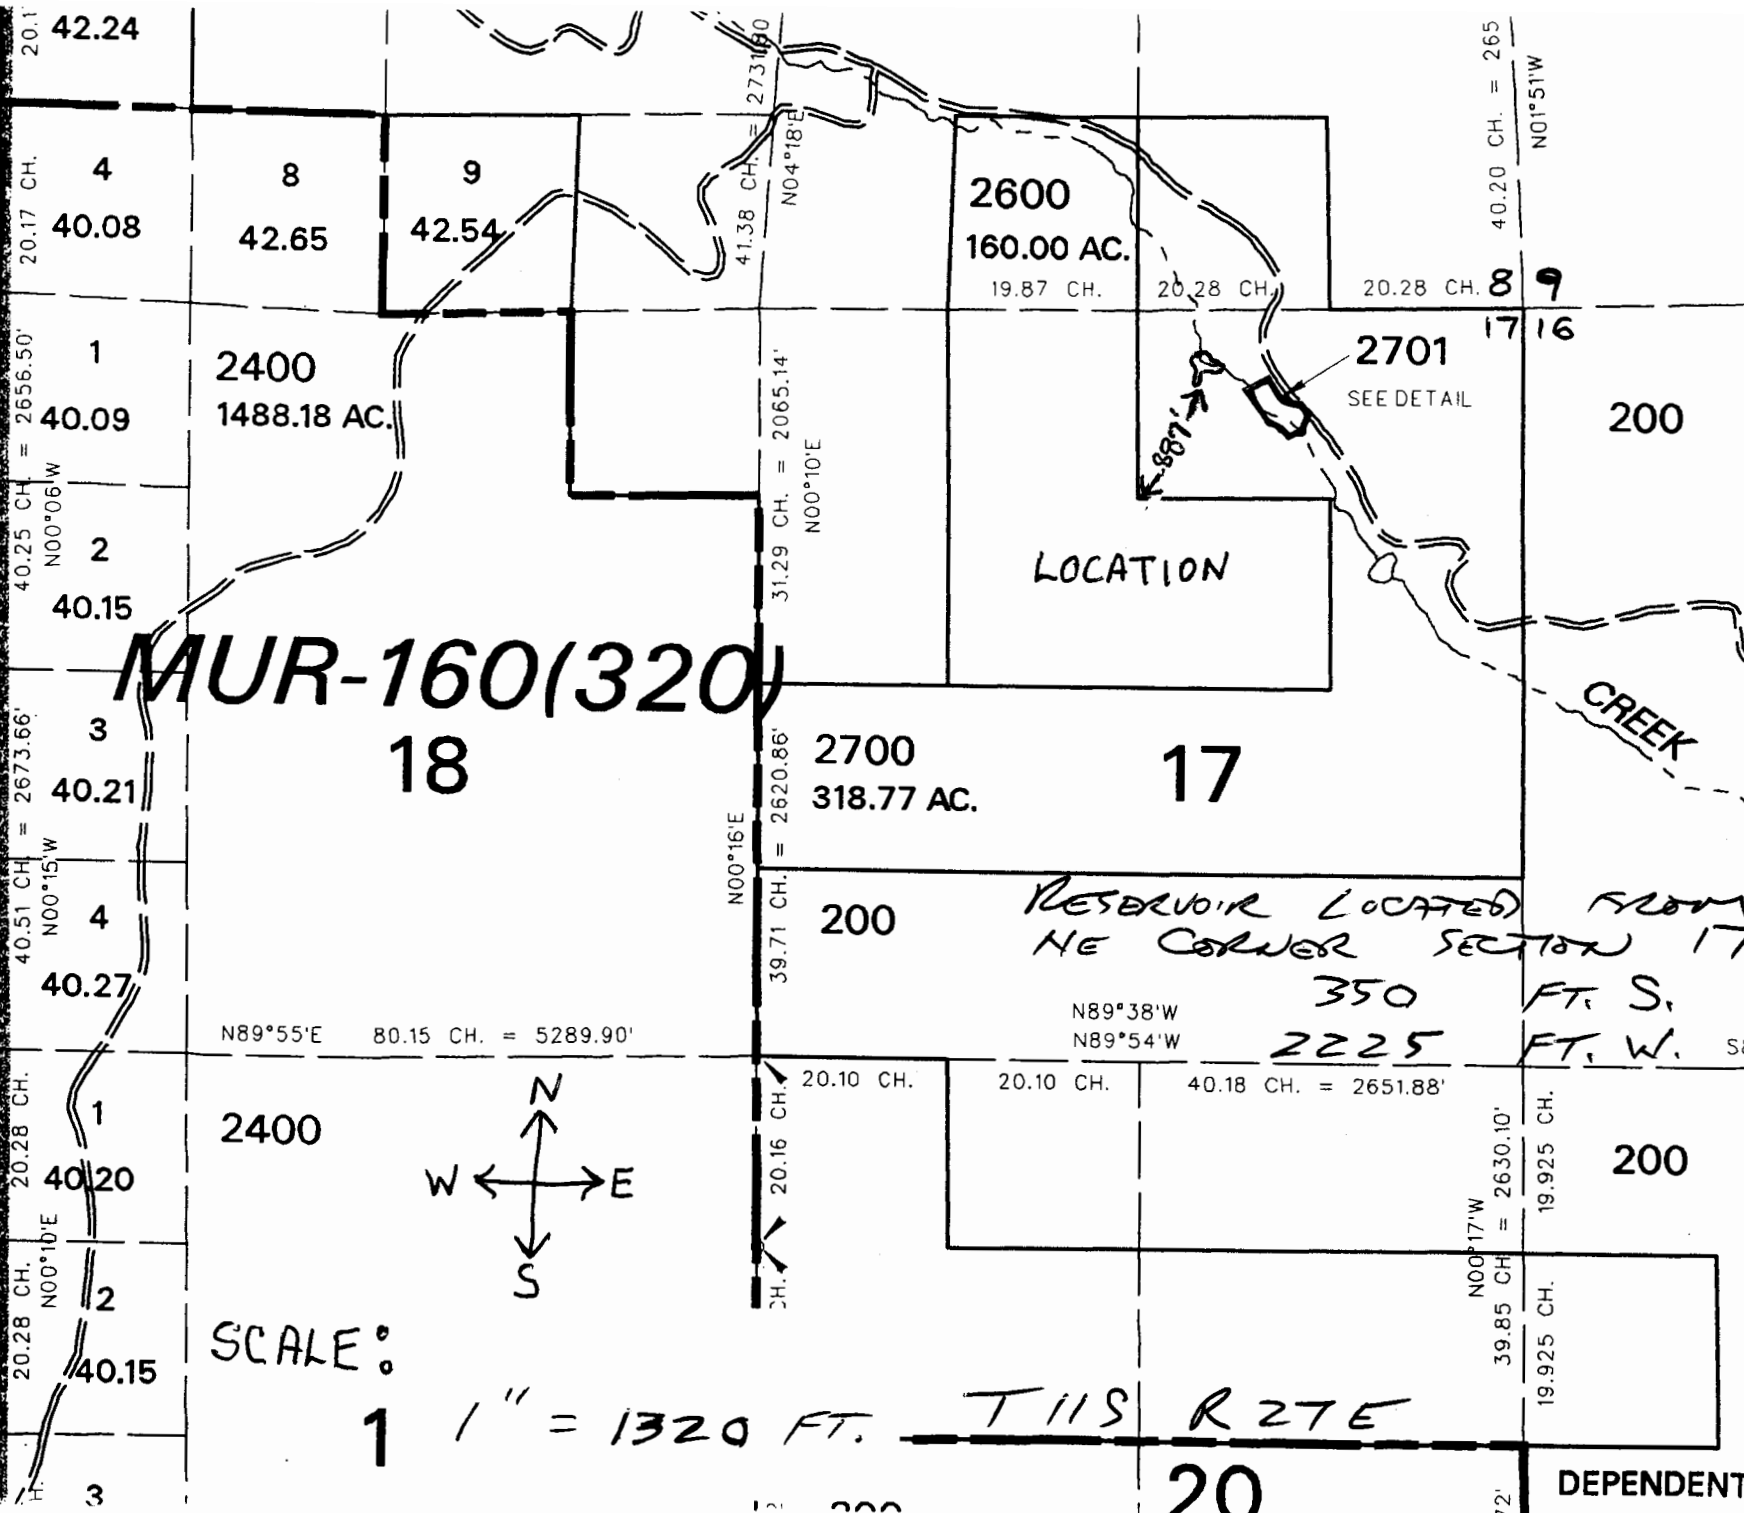

app no R 85889 Permit No R-13918