
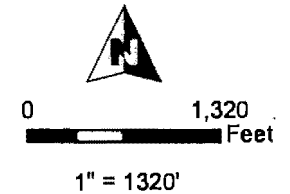



**T24S R30E, WM,
HARNEY COUNTY, OR**

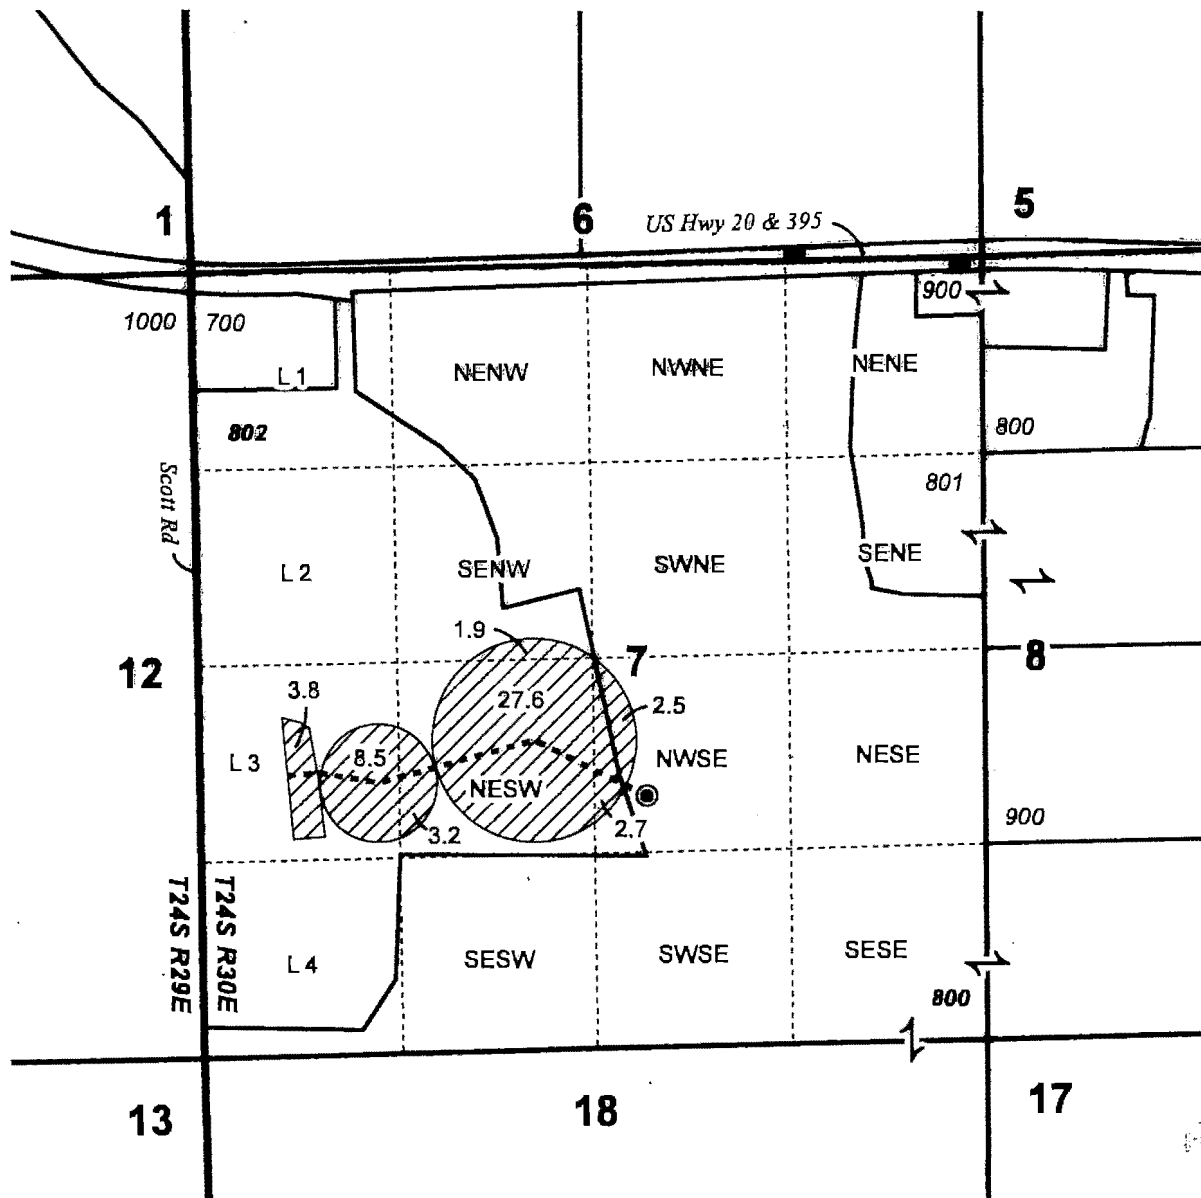

- Well & Meter
- Pipeline
- POU IR
- Township
- Section
- Quarter Quarter
- Tax Lot

Well (HARN 51557/L-96573) Location:

870' S, 3060' E of W 1/4 Cor Sec 7

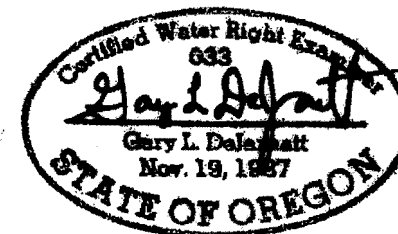

RENEWAL DATE 12/31/2021



CLAIM OF BENEFICIAL USE MAP
James C. & Elia A. Shepherd

This map is not intended
to provide legal dimensions
or locations of property
ownership lines.

Ap. G-17095 Permit G-16651

Date: 6/21/2021

Project #20096

WATER RIGHT SERVICES, LLC
PO BOX 1830, BEND, OR 97709
WWW.OREGONWATER.US CCB # 197121
johnshort@usa.com 541-389-2837