


HANLEY ENGINEERING, INC.
 P.O. BOX 701, 2043 MAIN STREET, BAKER CITY, OREGON 97814 (541) 523-3803

C.O.B.U. MAP
 W $\frac{1}{2}$ SW $\frac{1}{4}$, SE $\frac{1}{4}$ SW $\frac{1}{4}$ Section 31,
 Township 7 South, 39 East, W. M.

SEPT., 2015

Application # G-15569

Permit # G-15265

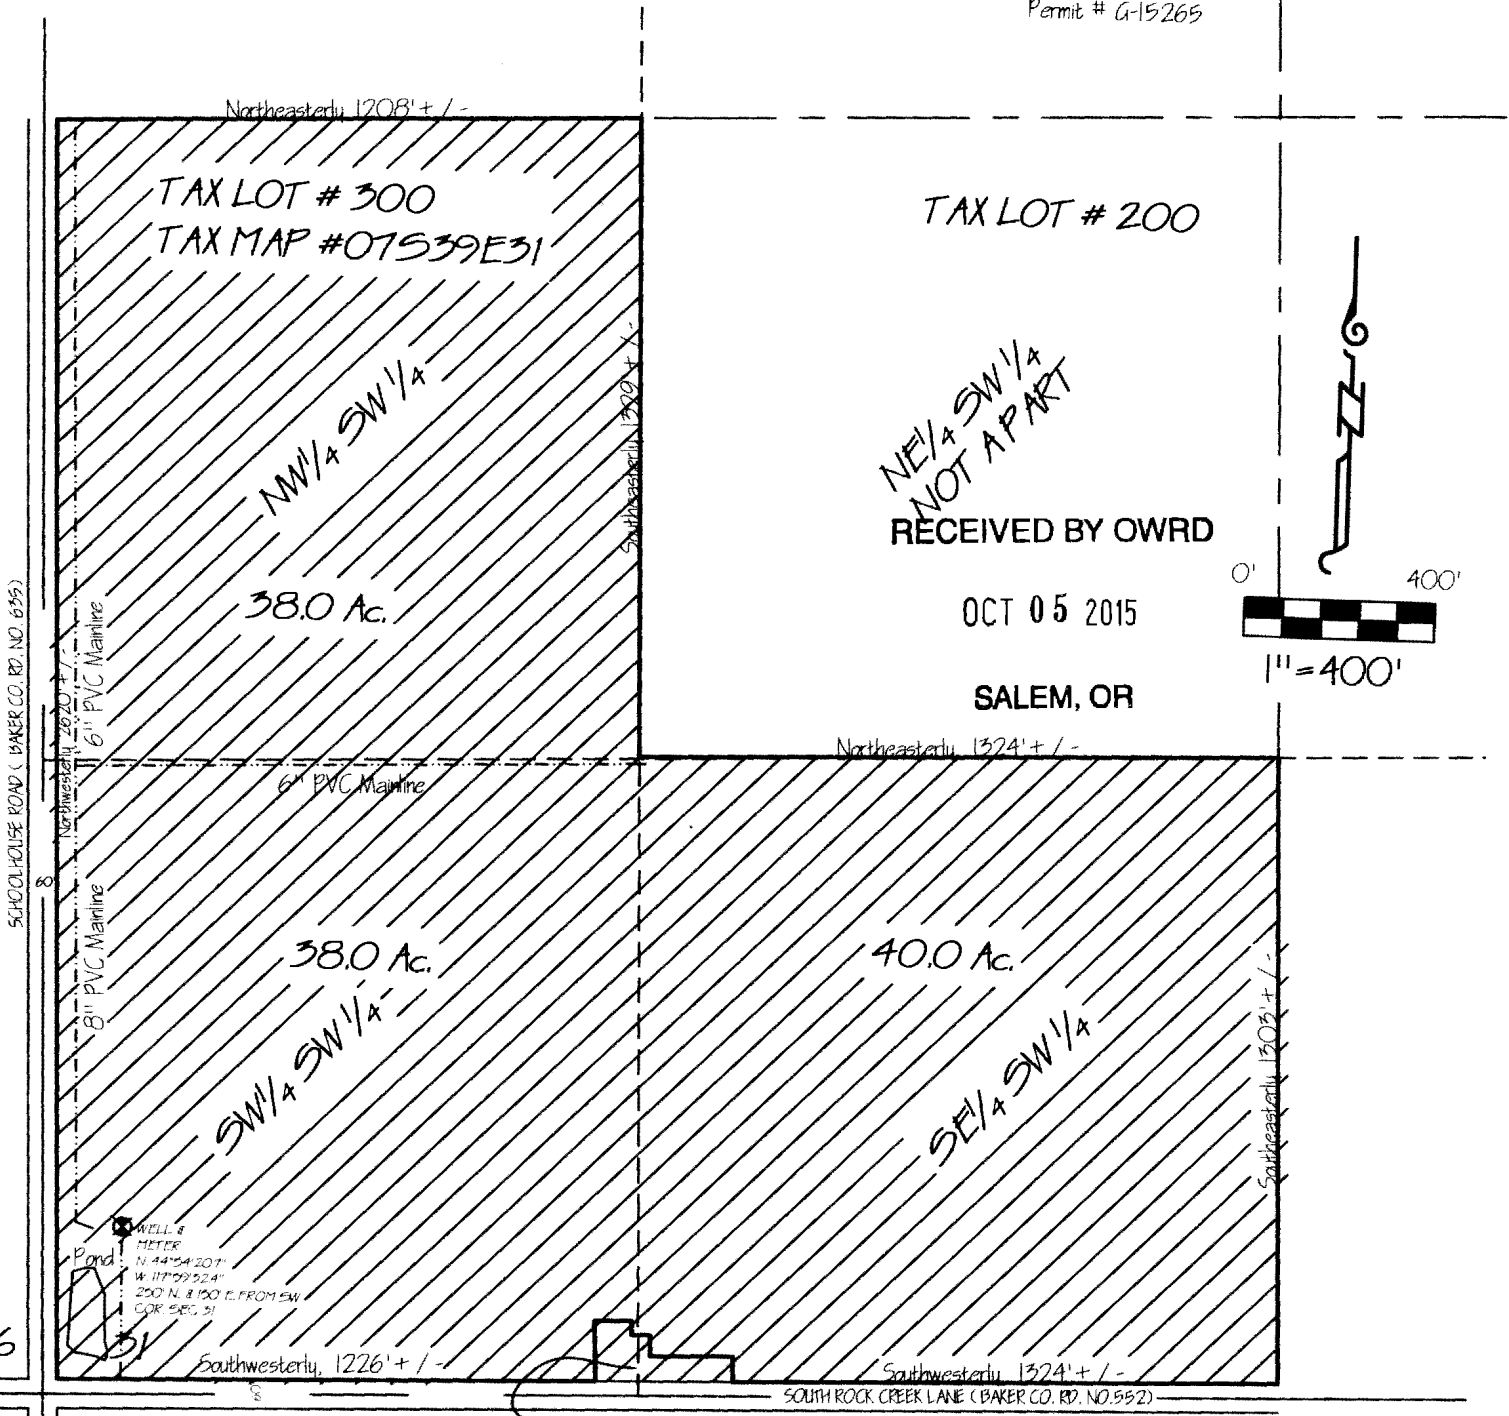


NE $\frac{1}{4}$ SW $\frac{1}{4}$
 NOT A PART

RECEIVED BY OWRD

OCT 05 2015

SALEM, OR

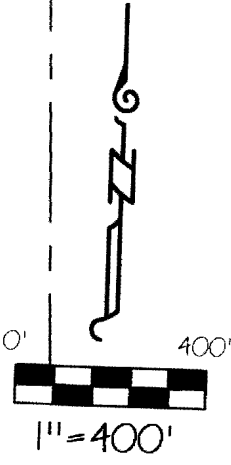

TAX LOTS # 100 & 200
 TAX MAP # 07539E31CC

LEGEND

- Well
- Mainline
- Meter

This map is not intended to provide legal dimensions or locations of property ownership lines.

