


LEGEND	
ALL A	SECTION LINE
	1/4 1/4 LINE
	TAX LOT LINE
	DITCH LINE
	BURIED PIPE
	ROAD
22 22 22 22	SECTION CORNER
TL0000	TAX LOT NUMBER
	POA-1 (WELL)
	RESERVOIR TANK
	AQUACULTURE PONDS
	OVERFLOW POND
NWNW	1/4 1/4

- THIS MAP WAS PREPARED FROM FIELD MEASUREMENTS, NAIP 2011 AERIAL PHOTOGRAPH, KLAMATH COUNTY TAX MAPS 40 9 27, 40 9 28, 40 9 34, AND 40 9 35.
- 2. THE PURPOSE OF THIS MAP IS TO IDENTIFY THE LOCATION OF THE WATER RIGHT ONLY, AND IS NOT INTENDED TO PROVIDE LEGAL DIMENSIONS OR LOCATIONS OF PROPERTY OWNERSHIP.
 - 5. FOR TAX LOT INFORMATION, SEE TAX MAP INCLUDED WITH THIS APPLICATION.
- DATE OF PRIORITY FOR THIS APPLICATION IS APRIL 2, 1997.

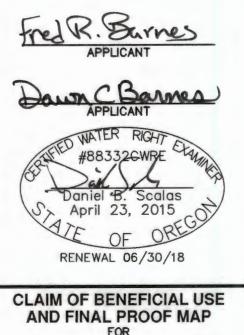

FOR FRED RONALD BARNES T40S, R9E, SEC. 27 & 34, WM KLAMATH COUNTY, OREGON PERMIT No. G-13285 APPLICATION No. G-14489