


TOWNSHIP 18 SOUTH, RANGE 5 WEST, W.M.

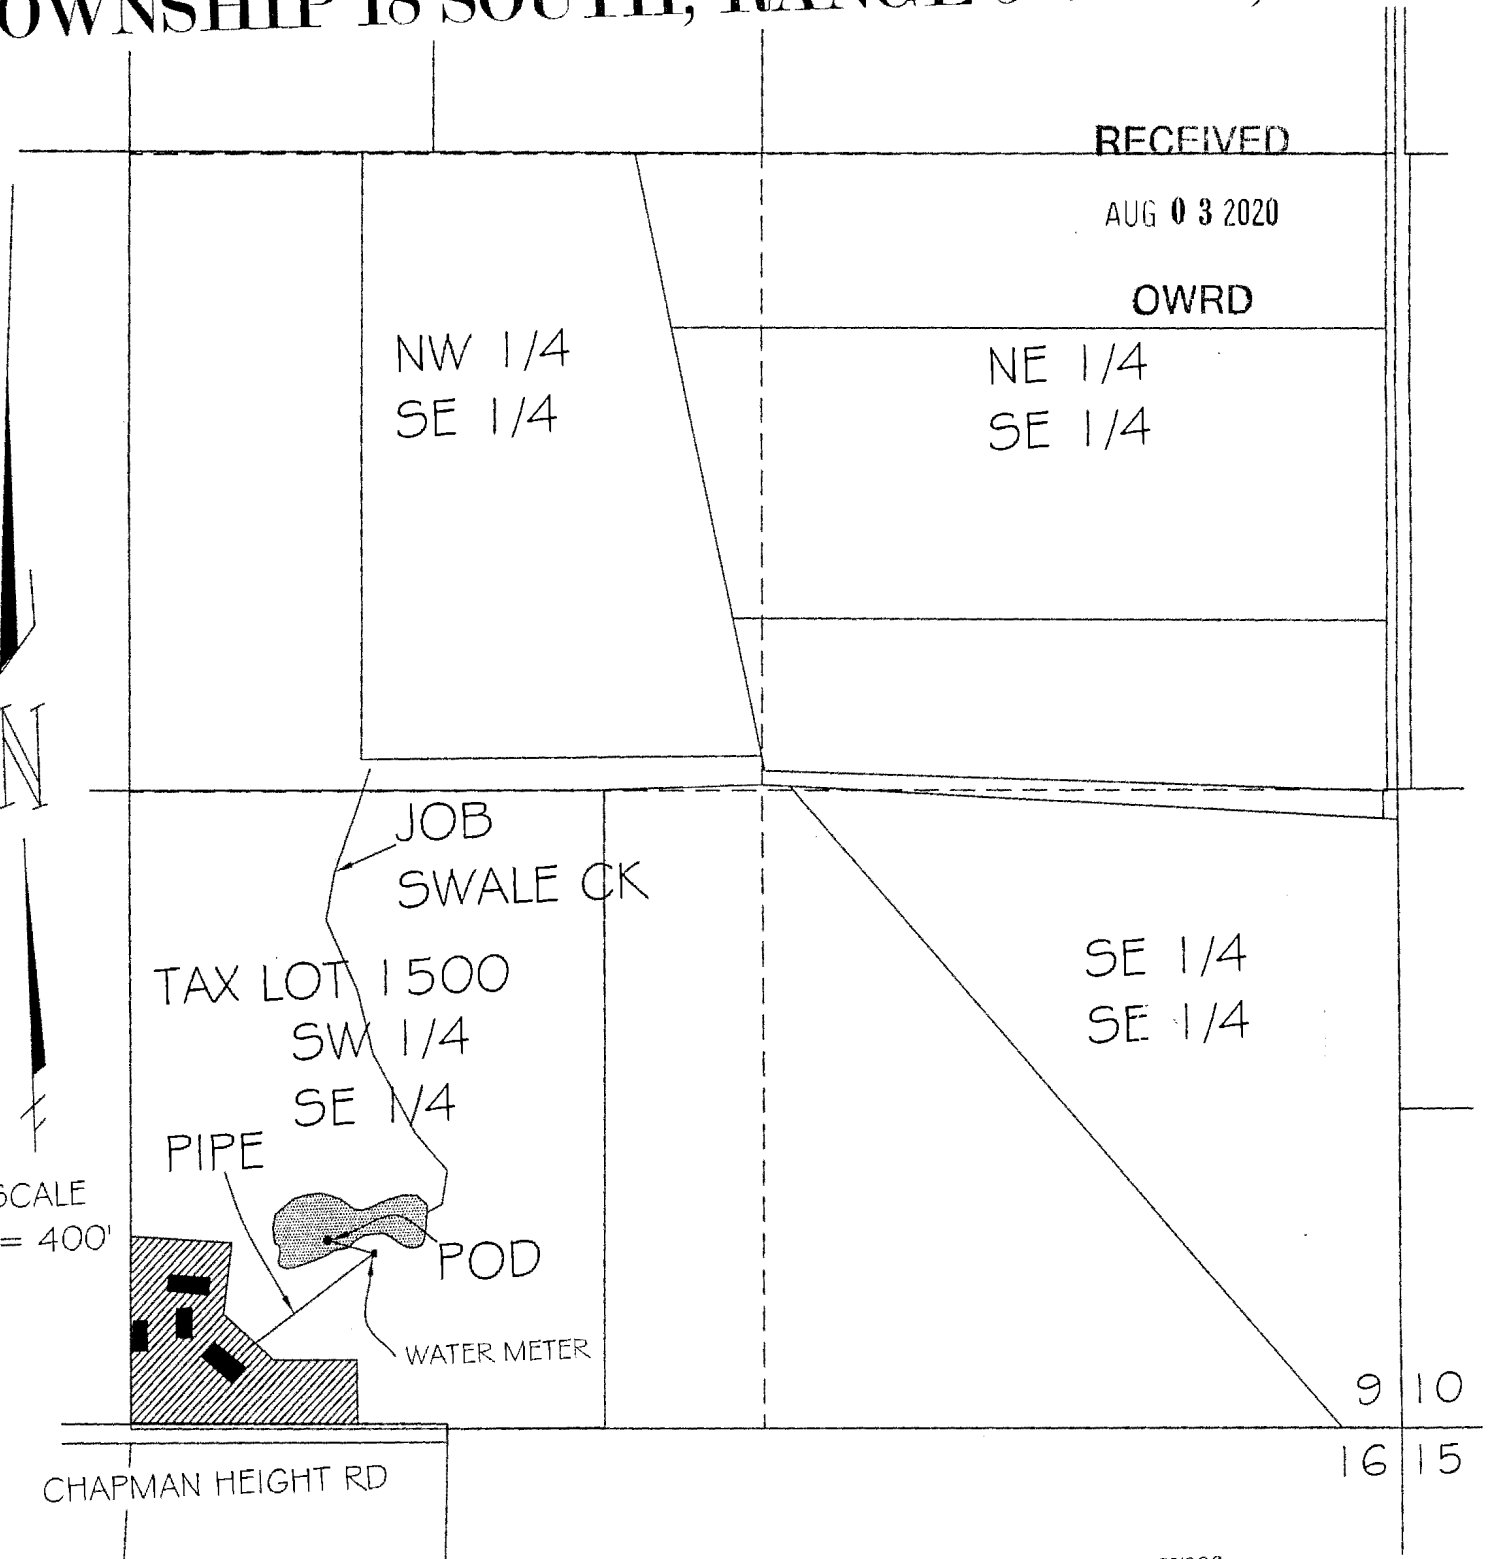

PERMIT S-54938 & R-15084

APPLICATION S-88050 & R-87996

FINAL PROOF SURVEY

FOR

RICHARD WALSH
26400 CHAPMAN HEIGHTS RD
EUGENE, OR 97402

BY

H. TIMOTHY FASSBENDER, PLS, CWRE

2896 SARAH LANE
EUGENE, OR 97408

JULY 24, 2020

POD LOCATION:

477 FEET NORTH & 2210 FEET WEST OF SE COR. SEC. 9

POND LOCATION:

520 FT NORTH & 2056 FEET WEST SE. COR. SEC 9

LEGEND

■ DENOTES BUILDING LOCATION

■ DENOTES POND LOCATION

■ DENOTES IRRIGATION AREA

AREA

POND STORAGE VOLUME = 6.00 ACRE FEET

IRRIGATION AREA WITHIN SW 1/4 SE 1/4 = 3.00 ACRES

NOTE

THIS MAP WAS PREPARED FOR THE PURPOSE
OF IDENTIFYING THE LOCATION OF THE WATER
RIGHT ONLY. IT IS NOT INTENDED TO PROVIDE
DIMENSIONS OR LOCATION OF PROPERTY
OWNERSHIP LINES.

