



**T2S, R1W, W.M.
SECTION 19
WASHINGTON COUNTY
APPLICATION R-83529, PERMIT R-12348
POND 4P
TUALATIN NATIONAL WILDLIFE REFUGE**

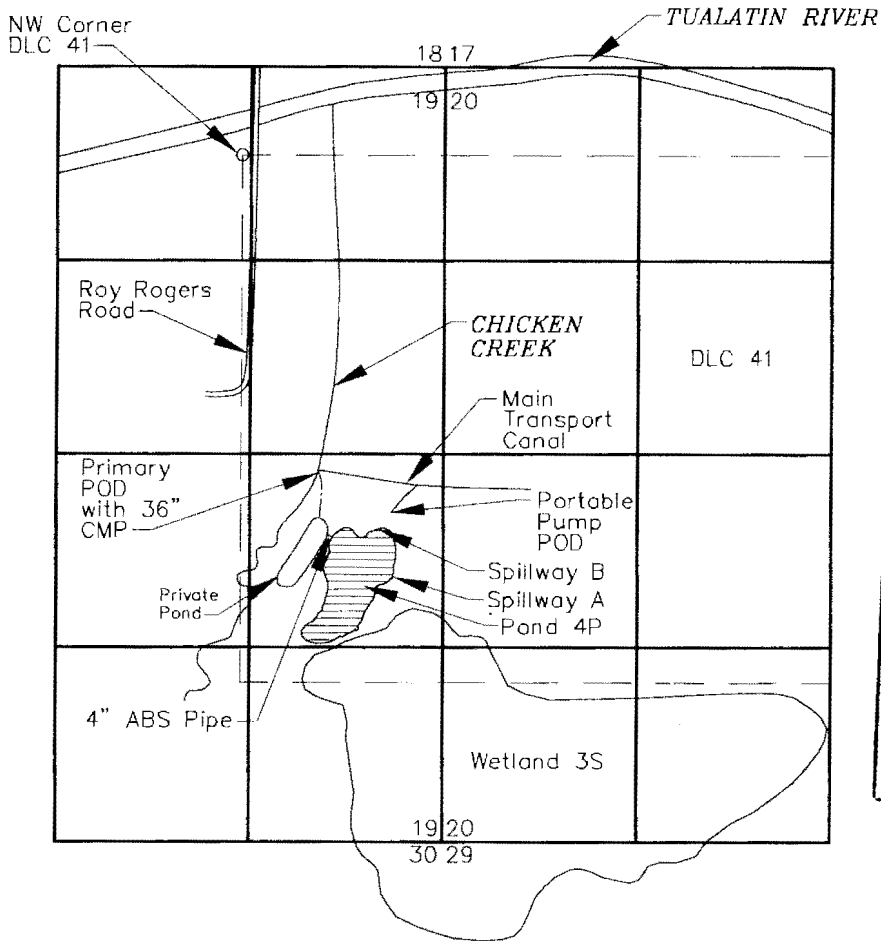

1 INCH = 1320 FEET



RECEIVED
OCT 01 2002
WATER RESOURCES DEPT
SALEM, OREGON

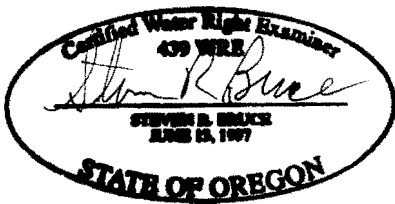

NOTES:

1. Primary point of diversion (POD) located 2,170 feet south and 520 feet east of NW corner of DLC 41.
2. Portable pump POD located 2,440 feet south and 1,020 feet east of NW corner DLC 41.
3. Survey completed on 9/10/02.

THE PURPOSE OF THIS MAP IS TO IDENTIFY THE LOCATION OF THE WATER RIGHT. IT IS NOT INTENDED TO PROVIDE INFORMATION RELATIVE TO THE LOCATION OF PROPERTY OWNERSHIP BOUNDARY LINES.



**CLAIM OF BENEFICIAL USE MAP
U.S. FISH AND WILDLIFE SERVICE**

FIGURE 1