

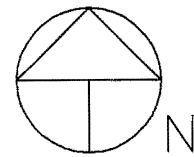


CLAIM OF BENEFICIAL USE MAP
 APPLICATION S-88113 - PERMIT S-55088
 SITUATED IN
 WEST HALF NORTHWEST ONE QUARTER SECTION 15
 EAST HALF NORTHEAST ONE QUARTER SECTION 16
 T.37S., R.2E., W.M.
 JACKSON COUNTY, OREGON
 FOR
 FAYE A. DUNCAN TRUSTEE
 5292 LOST CREEK ROAD
 EAGLE POINT, OR 97524

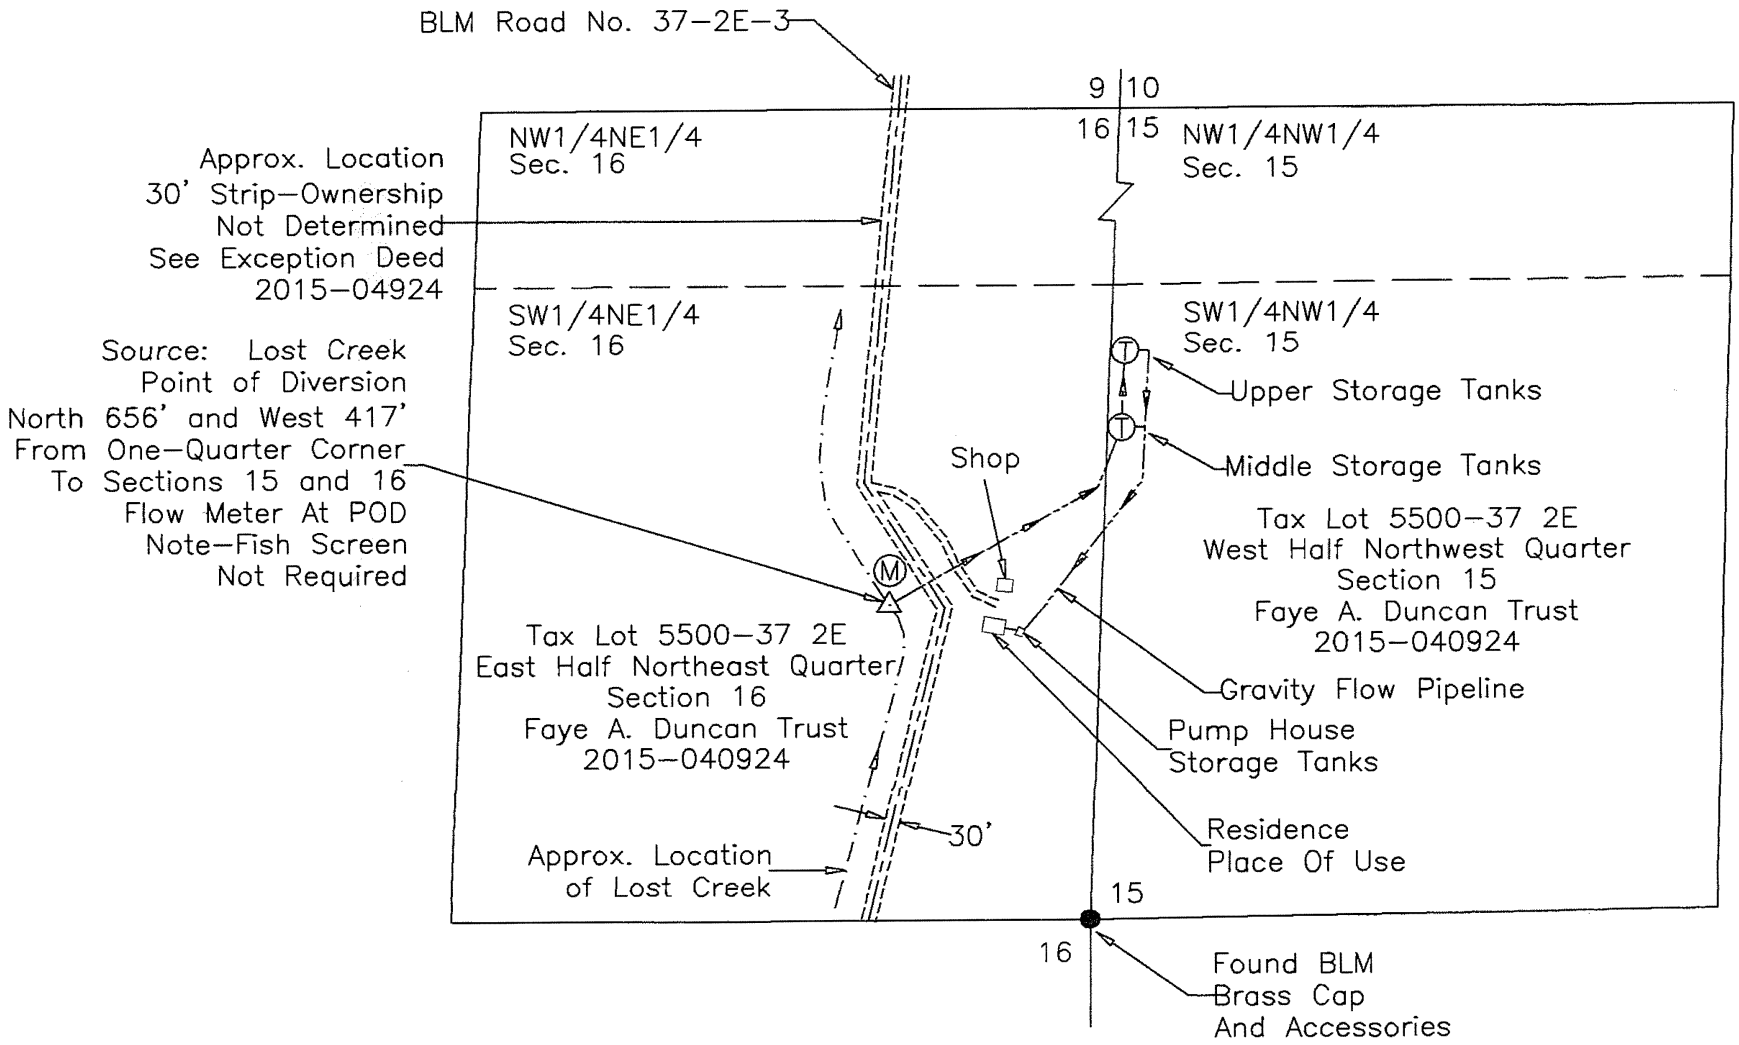

RECEIVED
 AUG 13 2020
 OWRD

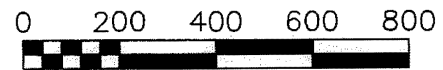

Scale 1" = 400'
 Date: July 27, 2020

This map was prepared for the purpose of identifying the location of a water right only and is not intended to provide legal dimensions or location of property ownership.

LEGEND

- Found Survey Monument
- Denotes Building
- △ Denotes Point Of Diversion
- Ⓜ Denotes Flow Meter
- Lost Creek--Approximate Location
- Denotes Driveway/Road
- Denotes Buried Pipeline Location Approximate
- Ⓣ Denotes Storage Tank



Renews: 12-31-21

HAROLD L. CENTER
 2604 David Lane
 Medford, OR. 97504
 Phone 541-535-6108
 Oregon Certificate No. 152

COBU MAP # 1245