




# CLAIM OF BENEFICIAL USE MAP

FOR: CITY of MYRTLE CREEK  
 BY: NATHAN R. REED, PE, CWRE  
 T29S, R5W, W.M. SECTION 32, DLC 40  
 APPLICATION NO. S-88370  
 PERMIT NO. S-55081




DATE SURVEYED: AUGUST 16, 2019

RECEIVED  
 SEP 03 2019

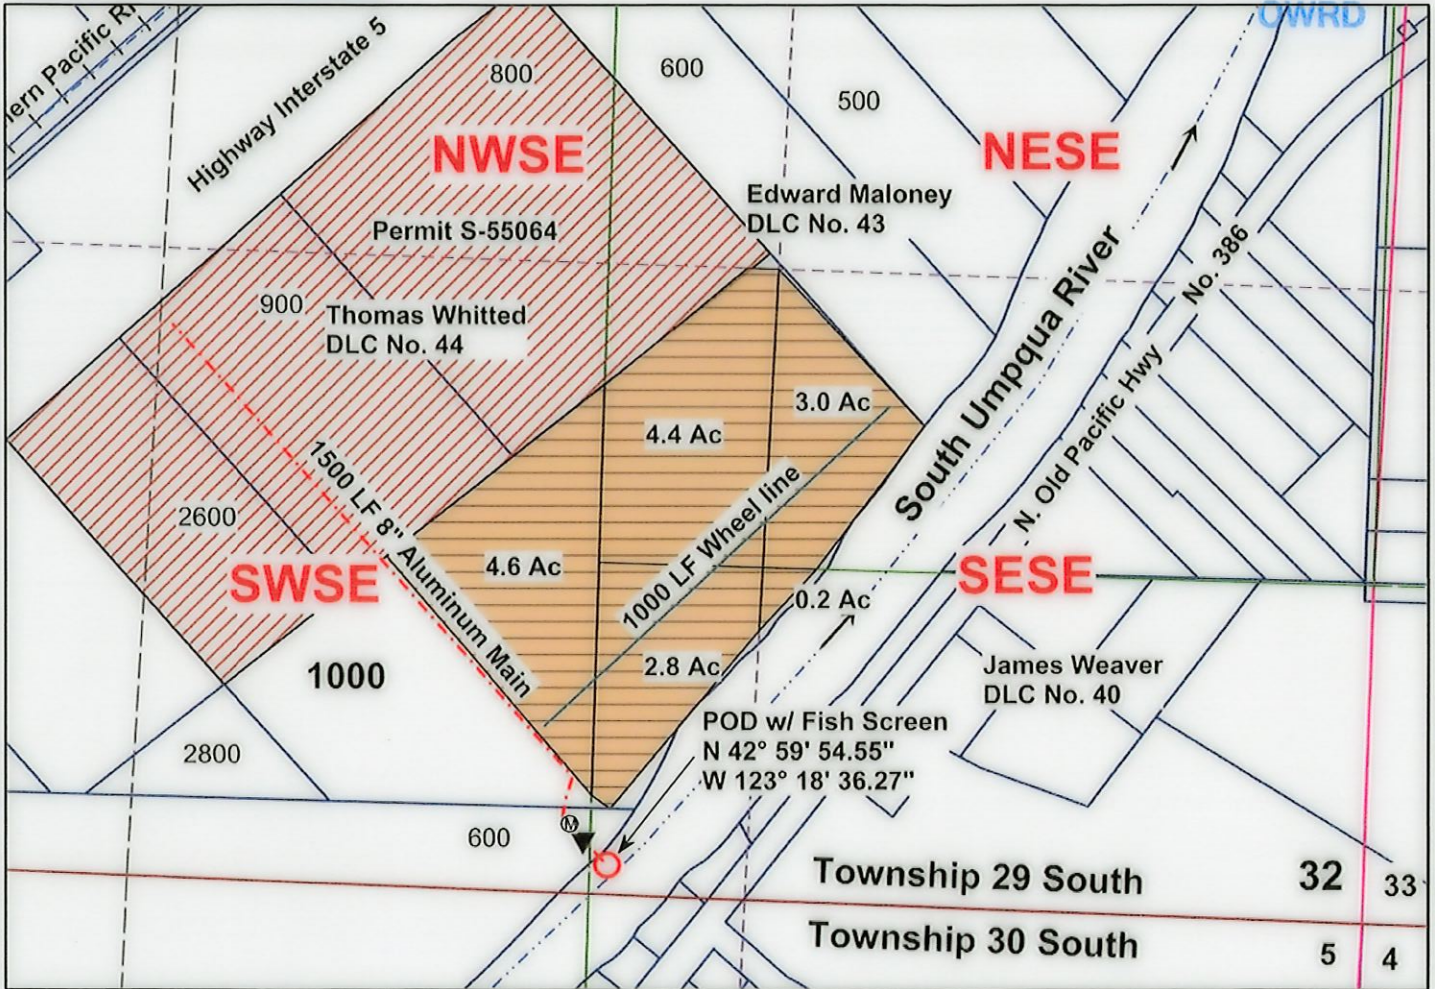

POD IS LOCATED 63 FEET NORTH AND 1024 FEET WEST FROM THE SE CORNER OF SECTION 32

Legend			
	POD		Stream
	PUMP		Pipeline
	Meter		Flow arrow
	Line		DLC
	Township		Quarter
	Section		Sixteenth
			Parcels

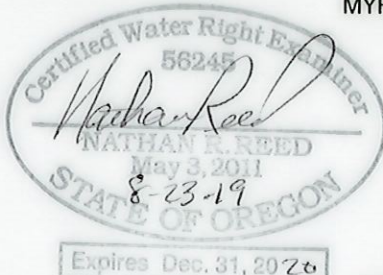

MAP PREPARED FOR:  
 CITY of MYRTLE CREEK  
 PO BOX 940  
 MYRTLE CREEK, OR 97457


THE PURPOSE OF THIS MAP IS TO IDENTIFY THE LOCATION OF THE WATER RIGHT. IT IS NOT INTENDED TO PROVIDE INFORMATION RELATIVE TO THE LOCATION OF PROPERTY OWNERSHIP BOUNDARY LINES.

MAP PREPARED BY:  
 NATHAN R. REED, P.E., CWRE  
 157 W. BODIE ST  
 ROSEBURG, OR 97471

*NR/WRD 9/13/22*