


T. 32 S., R. 5 W., W.M.

and 6 "

RECEIVED
MAY 9 1956
STATE ENGINEER
SALEM, OREGON

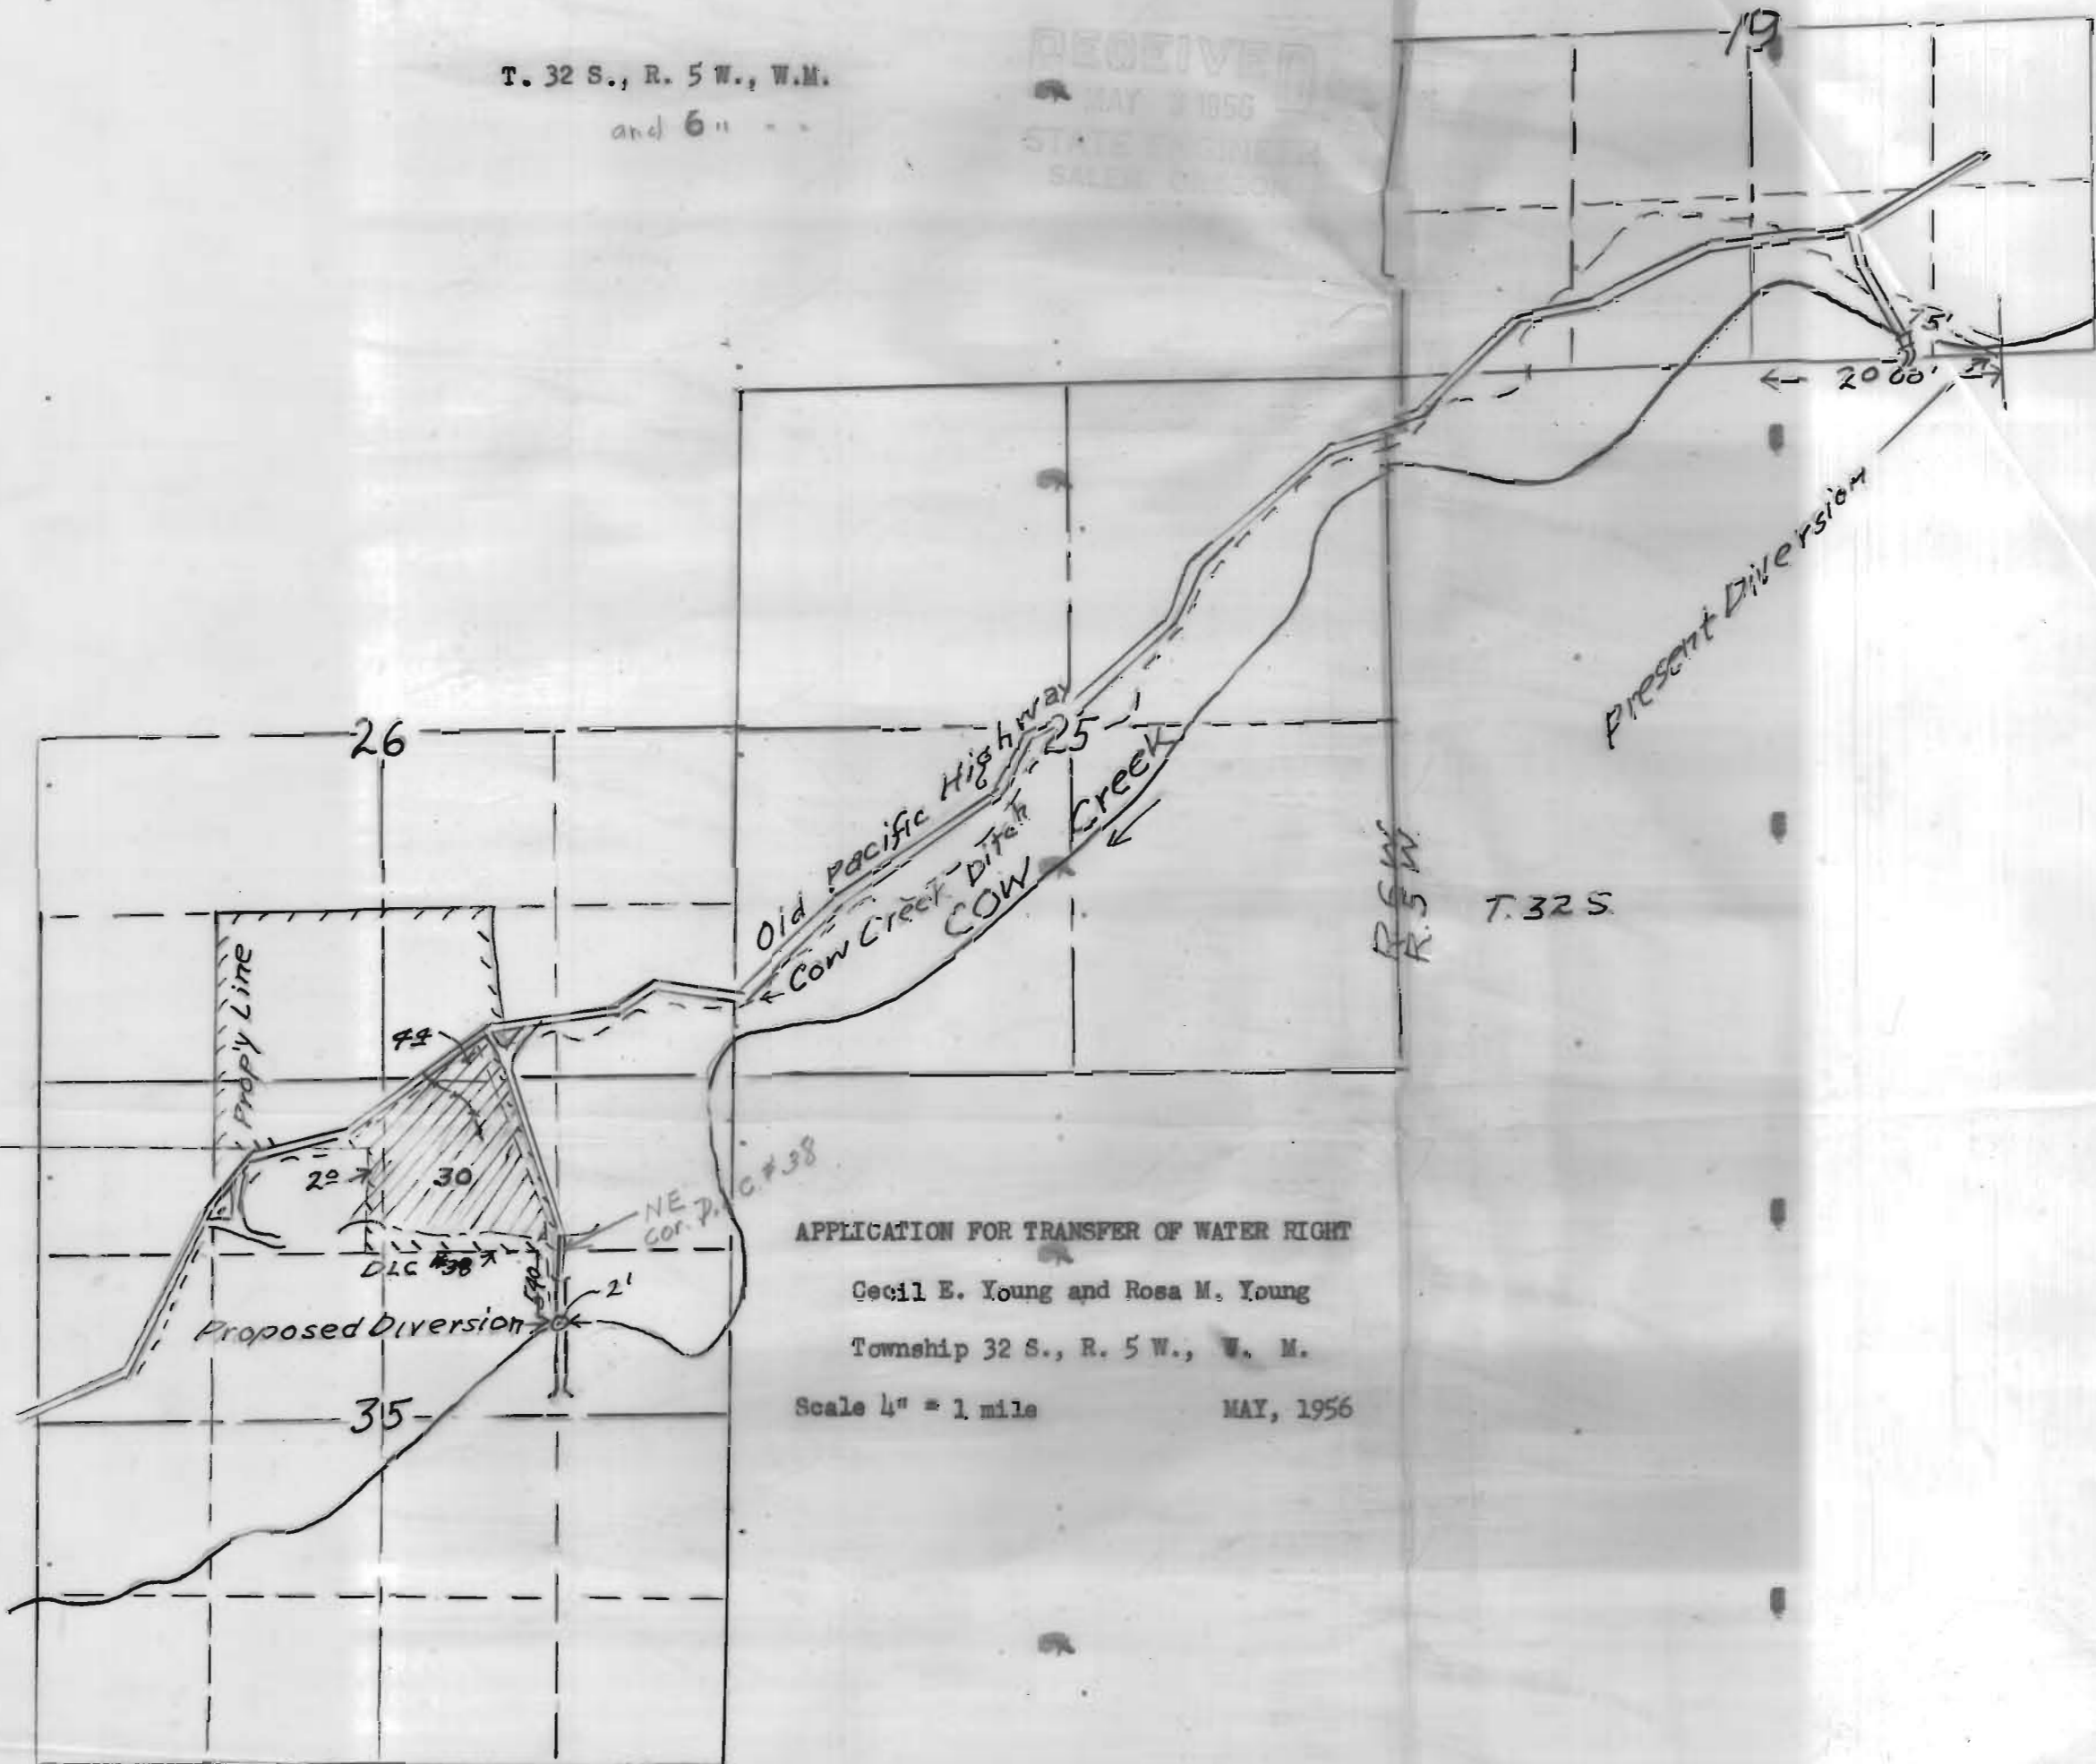

APPLICATION FOR TRANSFER OF WATER RIGHT

Cecil E. Young and Rosa M. Young

Township 32 S., R. 5 W., W. M.

Scale 4" = 1 mile

MAY, 1956