


COBU MAP #747



CLAIM OF BENEFICIAL USE MAP

SECTION 11+14 T1N R2W W.M.
WASHINGTON COUNTY, OREGON

COBU MAP T-12331, ADDITIONAL POAs ONLY.
CERTIFICATES: 90310, 90311, 88631, 89545 AND 89544.

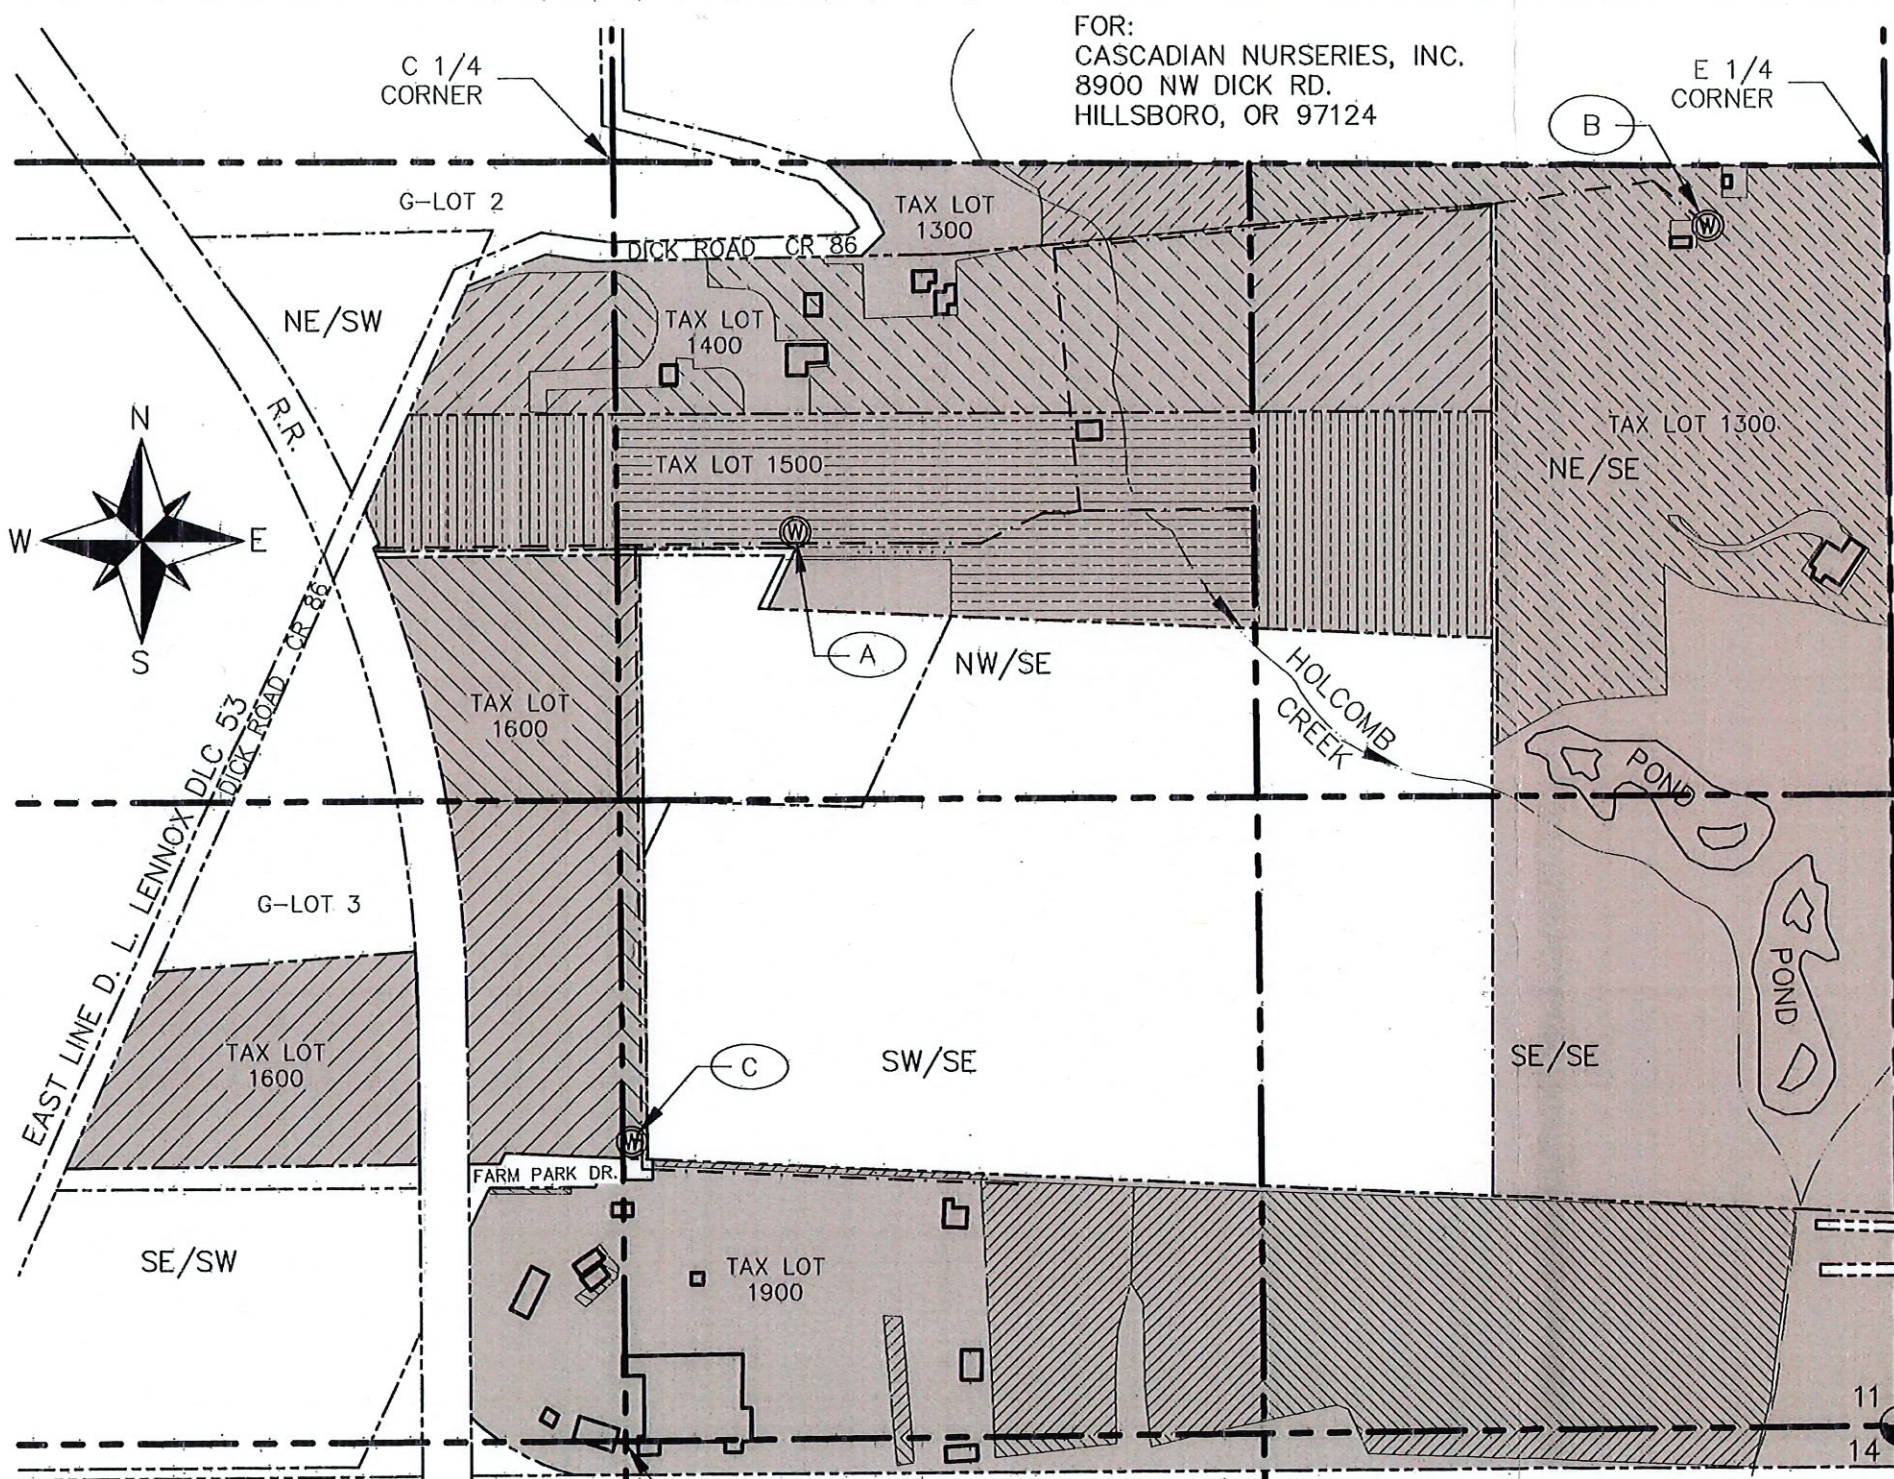

LEGEND	
(A)	POA, WELL #2 WITH METER IN PUMP HOUSE. 1880'N & 2280'W FROM THE SE CORNER OF SEC. 11
(B)	POA, WELL #3 WITH METER IN PUMP HOUSE. 2490'N & 370'W FROM THE SE CORNER OF SEC. 11
(C)	POA, WELL #4 WITH METER IN PUMP HOUSE. 620'N & 2630'W FROM THE SE CORNER OF SEC. 11
	BUILDINGS, TYPICAL
	SECTION AND QUARTER-QUARTER LINES
	PROPERTY LINES
	BURIED MAINLINES
	LAND OWNED BY CASCADIAN NURSERY INC. AND FARM HORTICULTURAL PARKPLACE, LLC.
	CERTIFICATE 90310 AREA OF IRRIGATION, TAX LOT 1300 POA WELL #2; APOAs WELLS #3 & #4
	CERTIFICATE 89545 AREA OF IRRIGATION, TAX LOT 1400 POAs WELLS #2 & #4; APOA WELL #3
	CERTIFICATE 89544 AREA OF IRRIGATION, TAX LOT 1500 POAs WELLS #2 & #4; APOA WELL #3
	CERTIFICATE 90311 AREA OF IRRIGATION, TAX LOT 1600 POA WELL #2; APOAs WELLS #3 & #4
	CERTIFICATE 88631 AREA OF IRRIGATION, TAX LOT 1900 POAs WELLS #2 & #3; APOA WELL #4

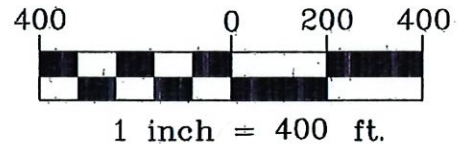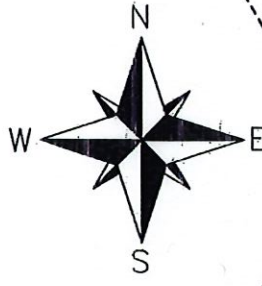

RECEIVED FEB 06 2020
OWRD
PREPARATION OF THIS MAP IS FOR THE PURPOSE OF IDENTIFYING THE LOCATION OF THE WATER RIGHT ONLY. THERE IS NO INTENT TO PROVIDE DIMENSIONS OR LOCATIONS OF PROPERTY OWNERSHIP LINES.

Stuntzner Engineering & Forestry, LLC
ENGINEERING * LAND SURVEYING * FORESTRY
PLANNING * WATER RIGHTS
COOS BAY*FOREST GROVE*DALLAS*JUCTION CITY

Stuntzner Engineering & Forestry, LLC
ENGINEERING * LAND SURVEYING * FORESTRY
PLANNING * WATER RIGHTS

2318-B PACIFIC AVENUE
FOREST GROVE, OREGON 97116

TEL: (503) 357-5717
FAX: (503) 357-5698
E-MAIL: INFO@STUNTZNER.COM

PROJECT: CASCADIAN NURSERY TRANSFER
DRAWING No.: 319-094 Cascadian Transfer COBU

DATE: 1-9-20
DRAWN BY: W.L. FLATZ

SOURCE OF MAP DATA:
ASSESSORS MAP, GOOGLE AIR PHOTO

COBU MAP # 1215