


T. 26 S., R. 19 E., W.M.

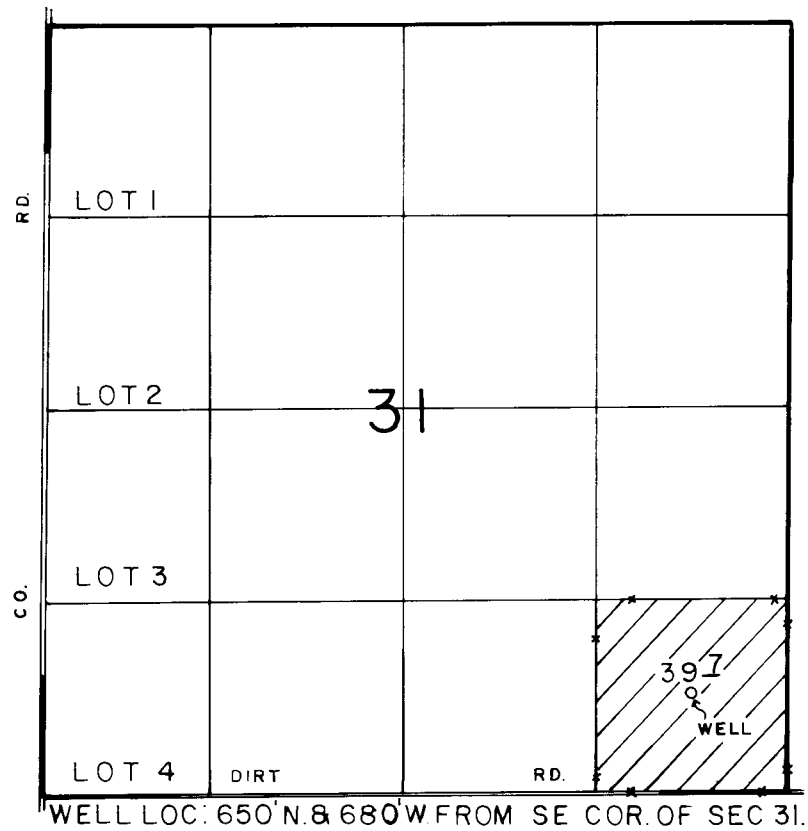

SCALE 1"=1320'

FINAL PROOF SURVEY

UNDER

TRANSFER NO. 5531
IN NAME OF

HARLAN F. & ELOISE OSTER

Surveyed APRIL 7, 1992, by B.W. BISHOP