


- ⊗ N. Fork Crooked River
- ⊗ C-84191 17^B acres (6/9/15)
- ⊗ C-84304 22^B acres (6/9/15)
- ⊗ C-667 111^B acres (1900)

N

Scale 1" = 1320'
(4" = 1 mile)

T-12404

Surveyed Sep 2; Oct 9 & 10, 2019

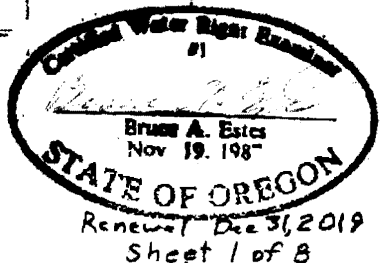

Claim of Beneficial Use Map
for
Waibel Ranches, LLC

This map is for the purpose of locating a water right only and has no intent to provide legal dimensions or the location of property lines.

ESTES SURVEYS
 PO Box 17518 60382 Arnold Rd
 Salem, OR 97305-7518 Bend, OR 97702
 (503) 585-7593 (541) 382-7391