

- ⊙ C-84192 115 acres (4/29/60 & 5/24/60)
Crooked River Supplemental
- ⊙ C-89610 2± acres (6/30/55)
- ⊙ C-75947 48± acres (1893)


Scale 1" = 1320'
(4" = 1 mile)

T-12404

Surveyed Sep 2; Oct 9 & 10, 2019

Claim of Beneficial Use Map
for
Waibel Ranches, LLC

This map is for the purpose of
locating a water right only
and has no intent to provide
legal dimensions or the locator
of property lines.

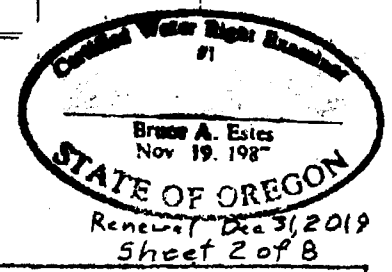

ESTES SURVEYS

PO Box 47518 60382 Arnold Rd
Salem, OR 97305-7519 Bend, OR 97702
(503) 686-7583 (541) 382-7391