


- ⊗ C-55659 741 acres Supp N. Fork C.R.
- ⊗ C-55659 392 acres Supp Crooked R.

Scale 1" = 1320'
(4" = 1 mile)

T-12404

Surveyed Sep 2; Oct 9 & 10, 2019

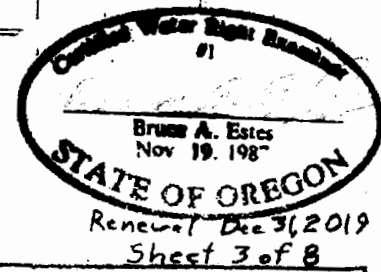



Claim of Beneficial Use Map
for
Waibel Ranches, LLC

This map is for the purpose of locating a water right only and has no intent to provide legal dimensions or the locator of property lines.

ESTES SURVEYS
 PO Box 17518 60382 Arnold Rd
 Salem, OR 97305-7519 Bend, OR 97702
 (503) 686-7593 (541) 382-7381

T. 17S, R. 21E, W.M.

This map is for the purpose of locating a water right only and has no intent to provide legal dimensions or the location of property lines.

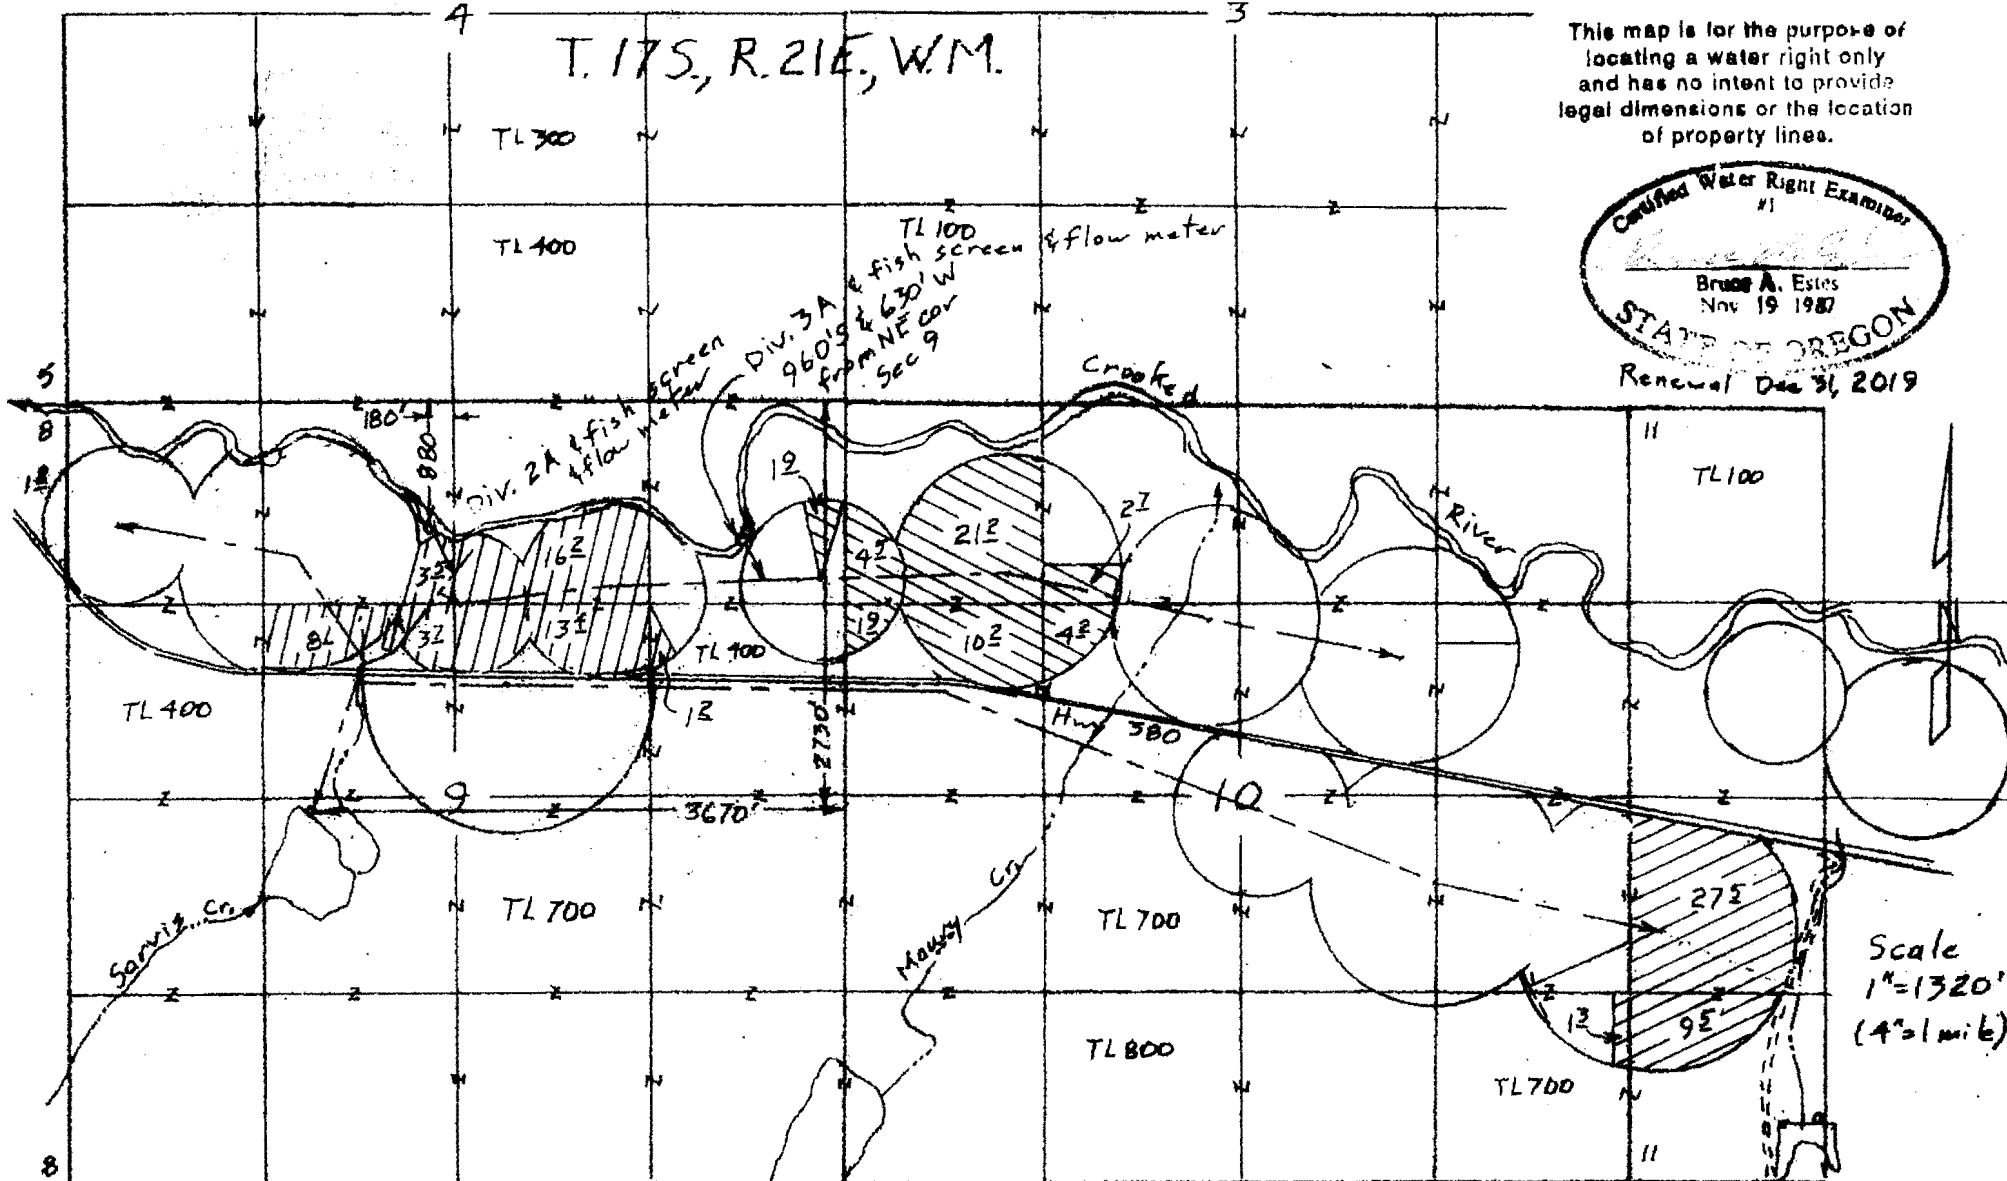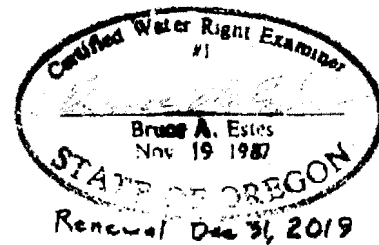

- ⊖ Crooked River
- ⊖ C-34225 46 1/2 acres (1956)
- ⊖ C-84305 46 1/2 acres (1960)

- ⊖ C-55659 38 3/4 acres (1970)



Claim of Beneficial Use Map
for
Waibel Ranches, LLC

T-12404

ESTES SURVEYS, LLC
 PO Box 17518
 Salem, OR 97305-7518
 (503) 363-7588
 60382 Arnold Rd
 Bend, OR 97702
 (541) 382-7391

T. 17S, R. 21E, W. 1M

This map is for the purpose of locating a water right only and has no intent to provide legal dimensions or the location of property lines.

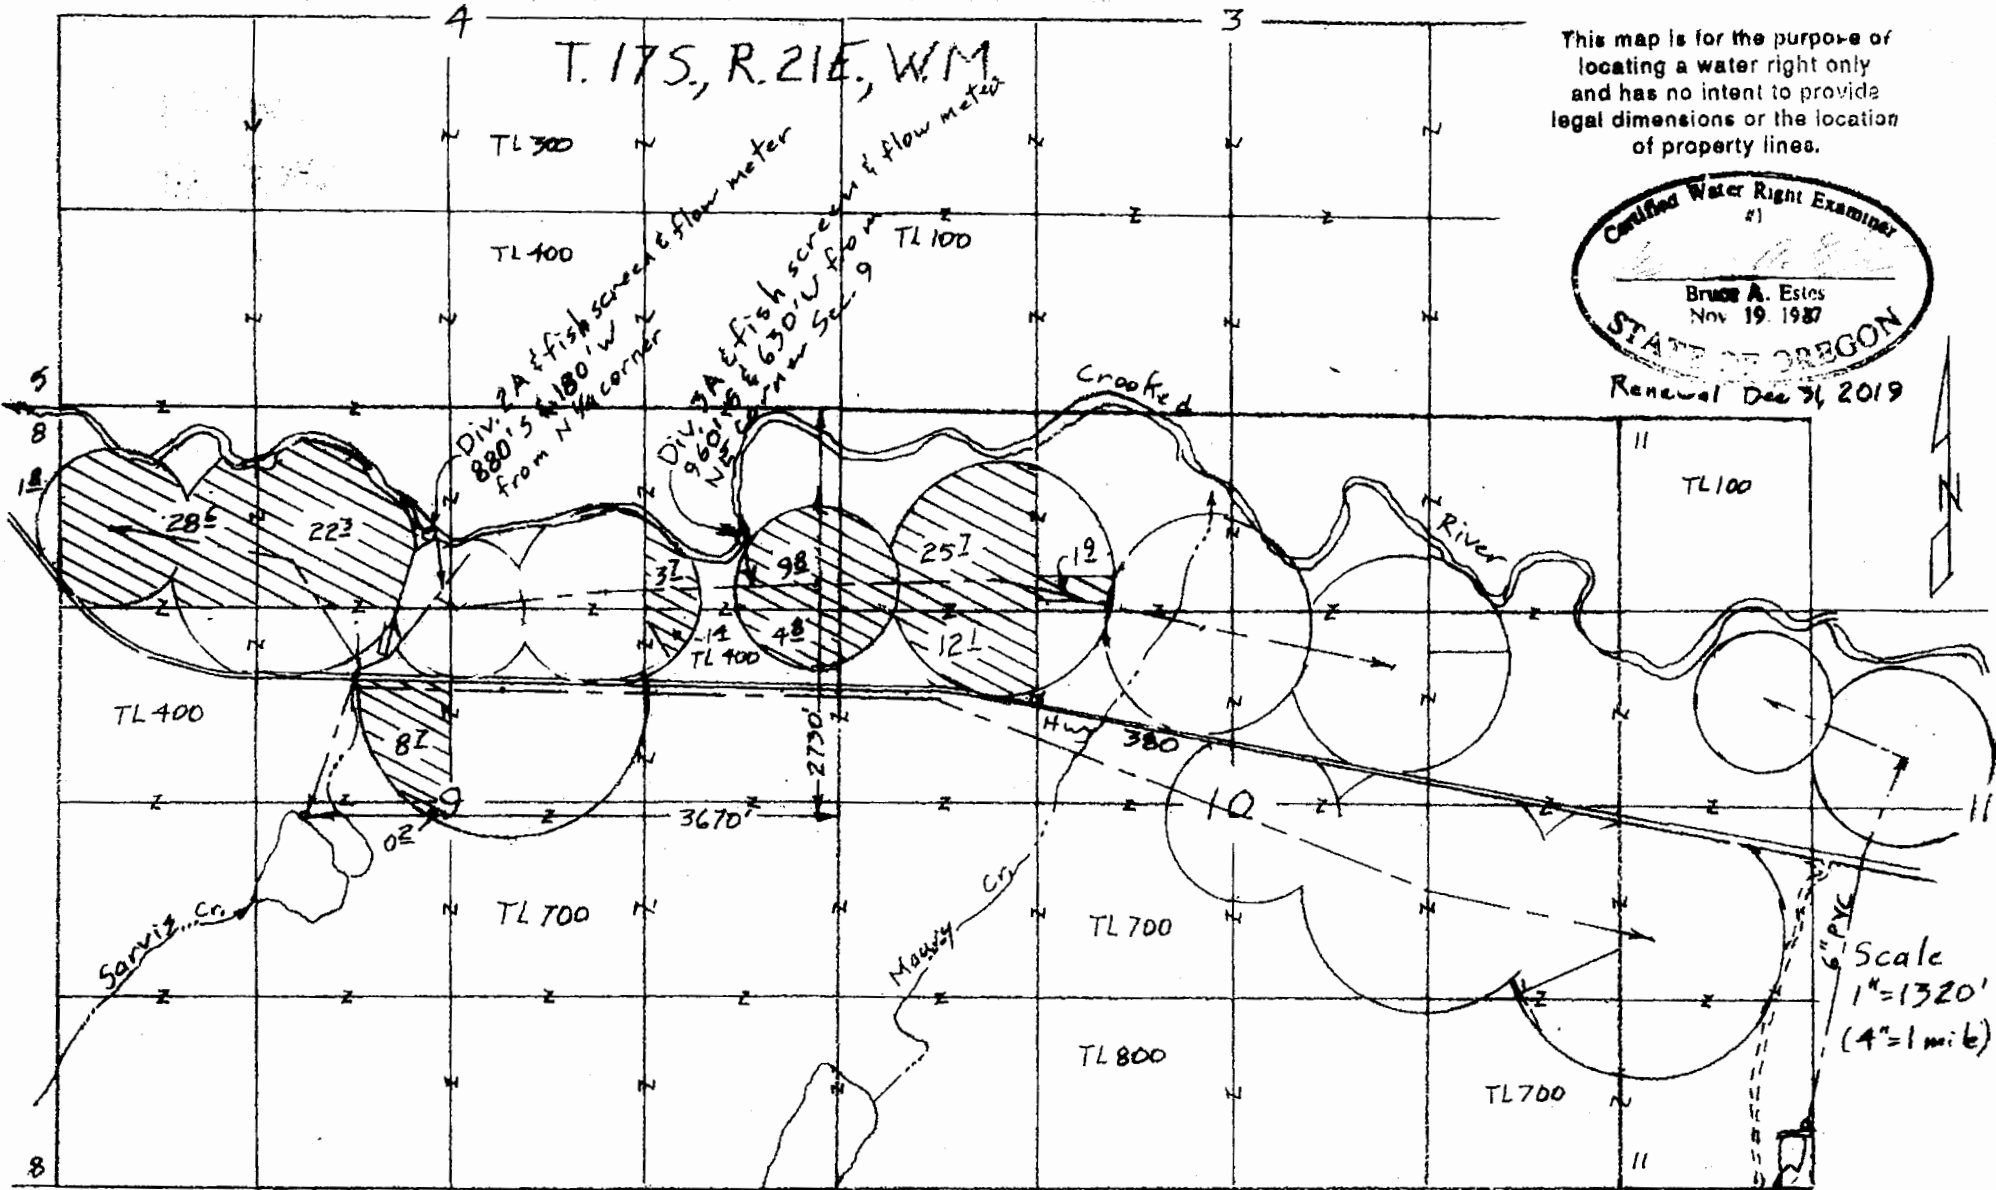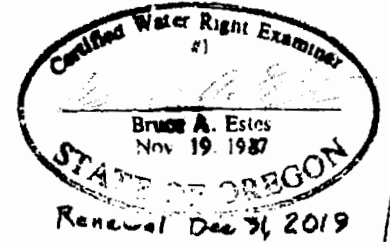

Surveyed Sep. 2, Oct 9 & 10, 2019

⊗ C-55659 119± acres (1970)
Crooked River

Claim of Beneficial Use Map
for
Waibel Ranches, LLC

T-12404

Sheet 8 of 8

ESTES SURVEYS, LLC
 PO Box 17518
 Salem, OR 97305-7518
 (503) 588-7588
 80382 Arnold Rd
 Bend, OR 97702
 (541) 382-7391

Scale
1" = 1320'
(4" = 1 mile)