
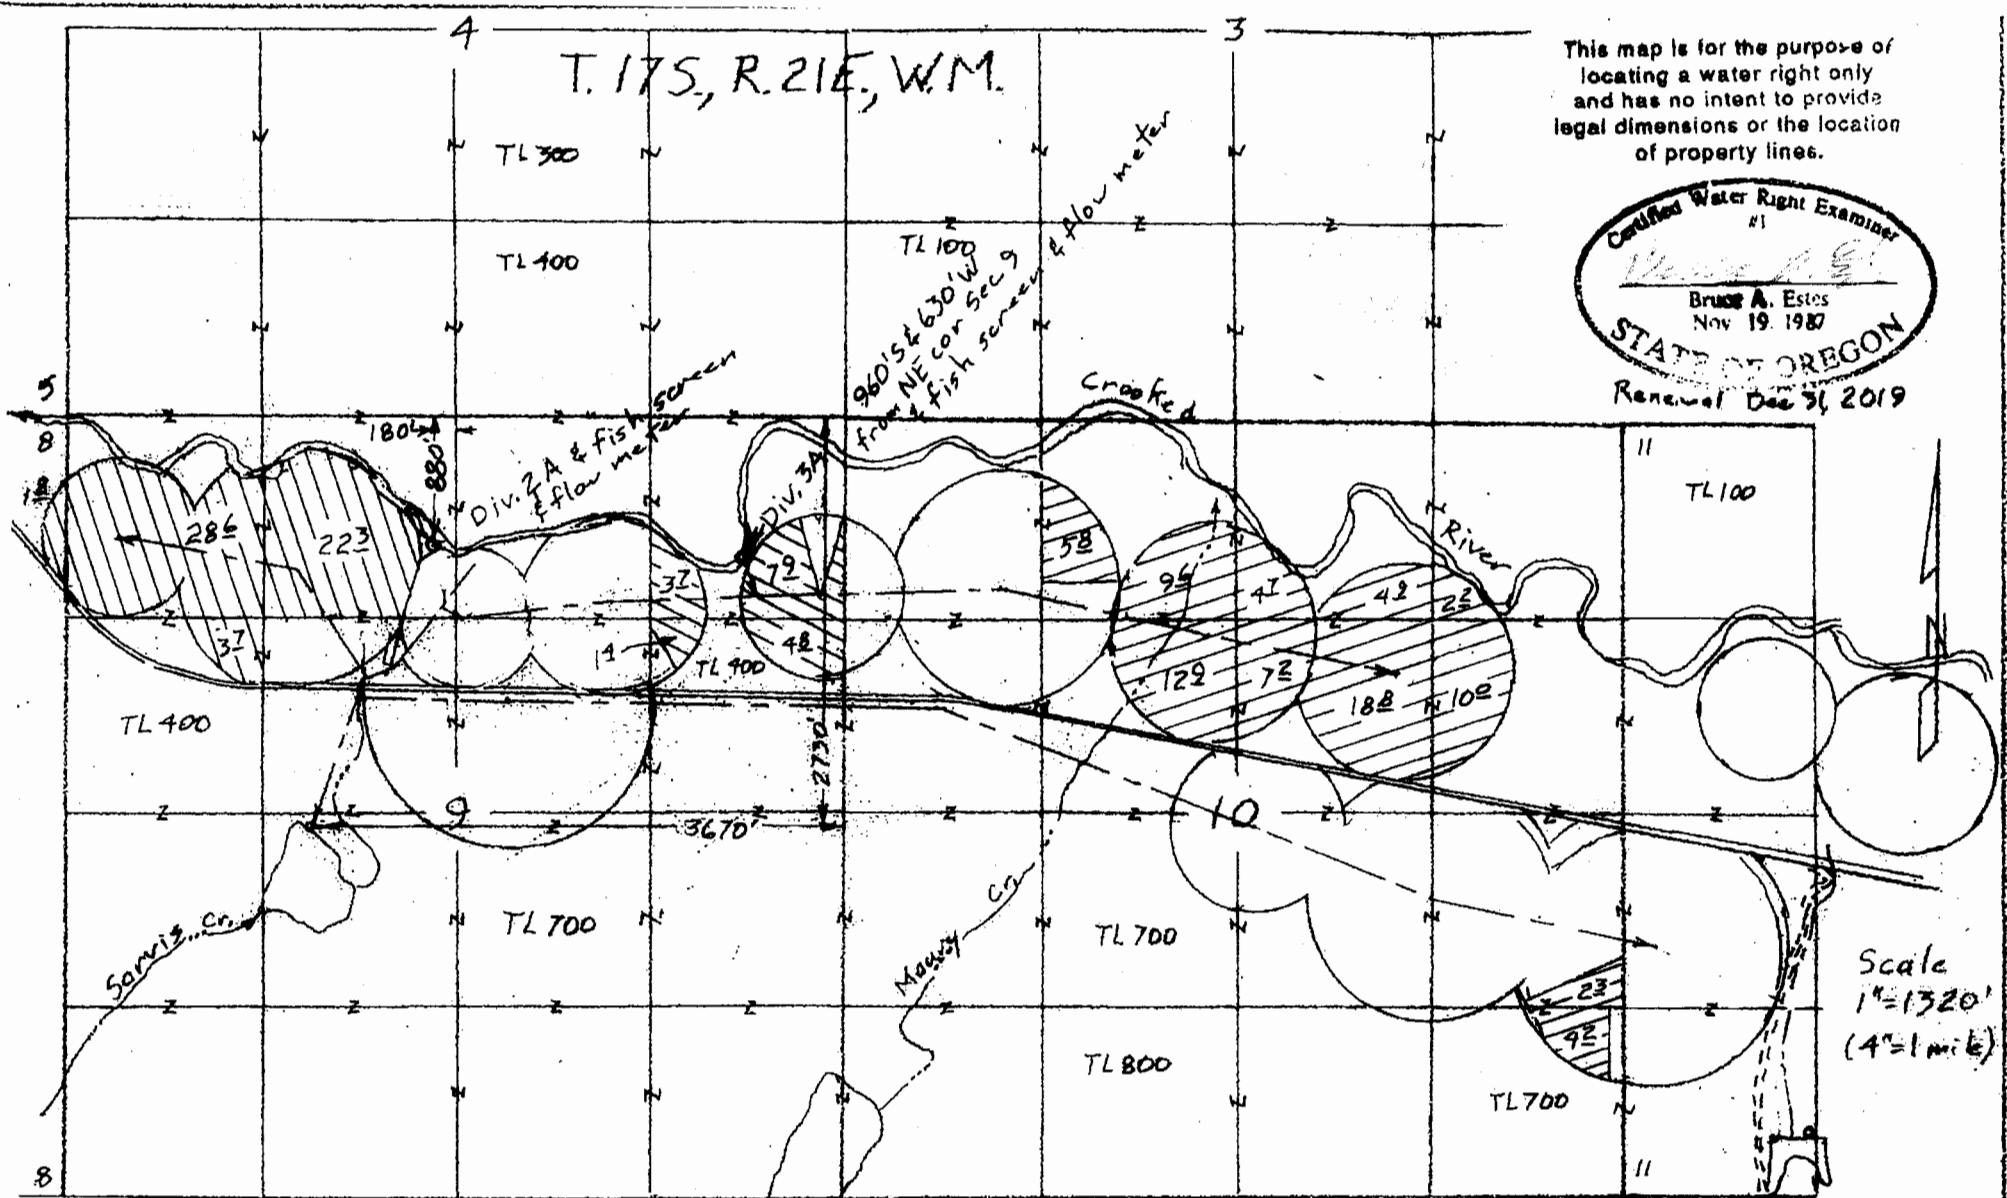


T. 17S, R. 21E, W.M.

This map is for the purpose of locating a water right only and has no intent to provide legal dimensions or the location of property lines.

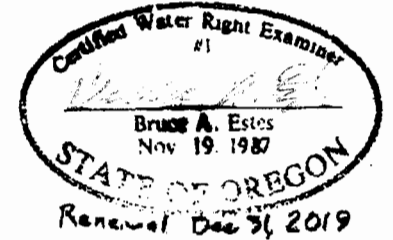

- Crooked River
C-84192 17.8 acres (1960)
- ⊗ Sarvis Cr. & Crooked R.
C-52520 56.4 acres (1950)

- Crooked River
C-89147 82.6 acres (1959)

Claim of Beneficial Use Map
for
Waibel Ranches, LLC



T-12404

ESTES SURVEYS, LLC
 PO Box 47518 Salem, OR 97305-7518 (503) 585-7588
 60382 Arnold Rd Bend, OR 97702 (541) 382-7391

Sheet 4 of 8

T. 17S, R. 21E, W.M.


This map is for the purpose of locating a water right only and has no intent to provide legal dimensions or the location of property lines.

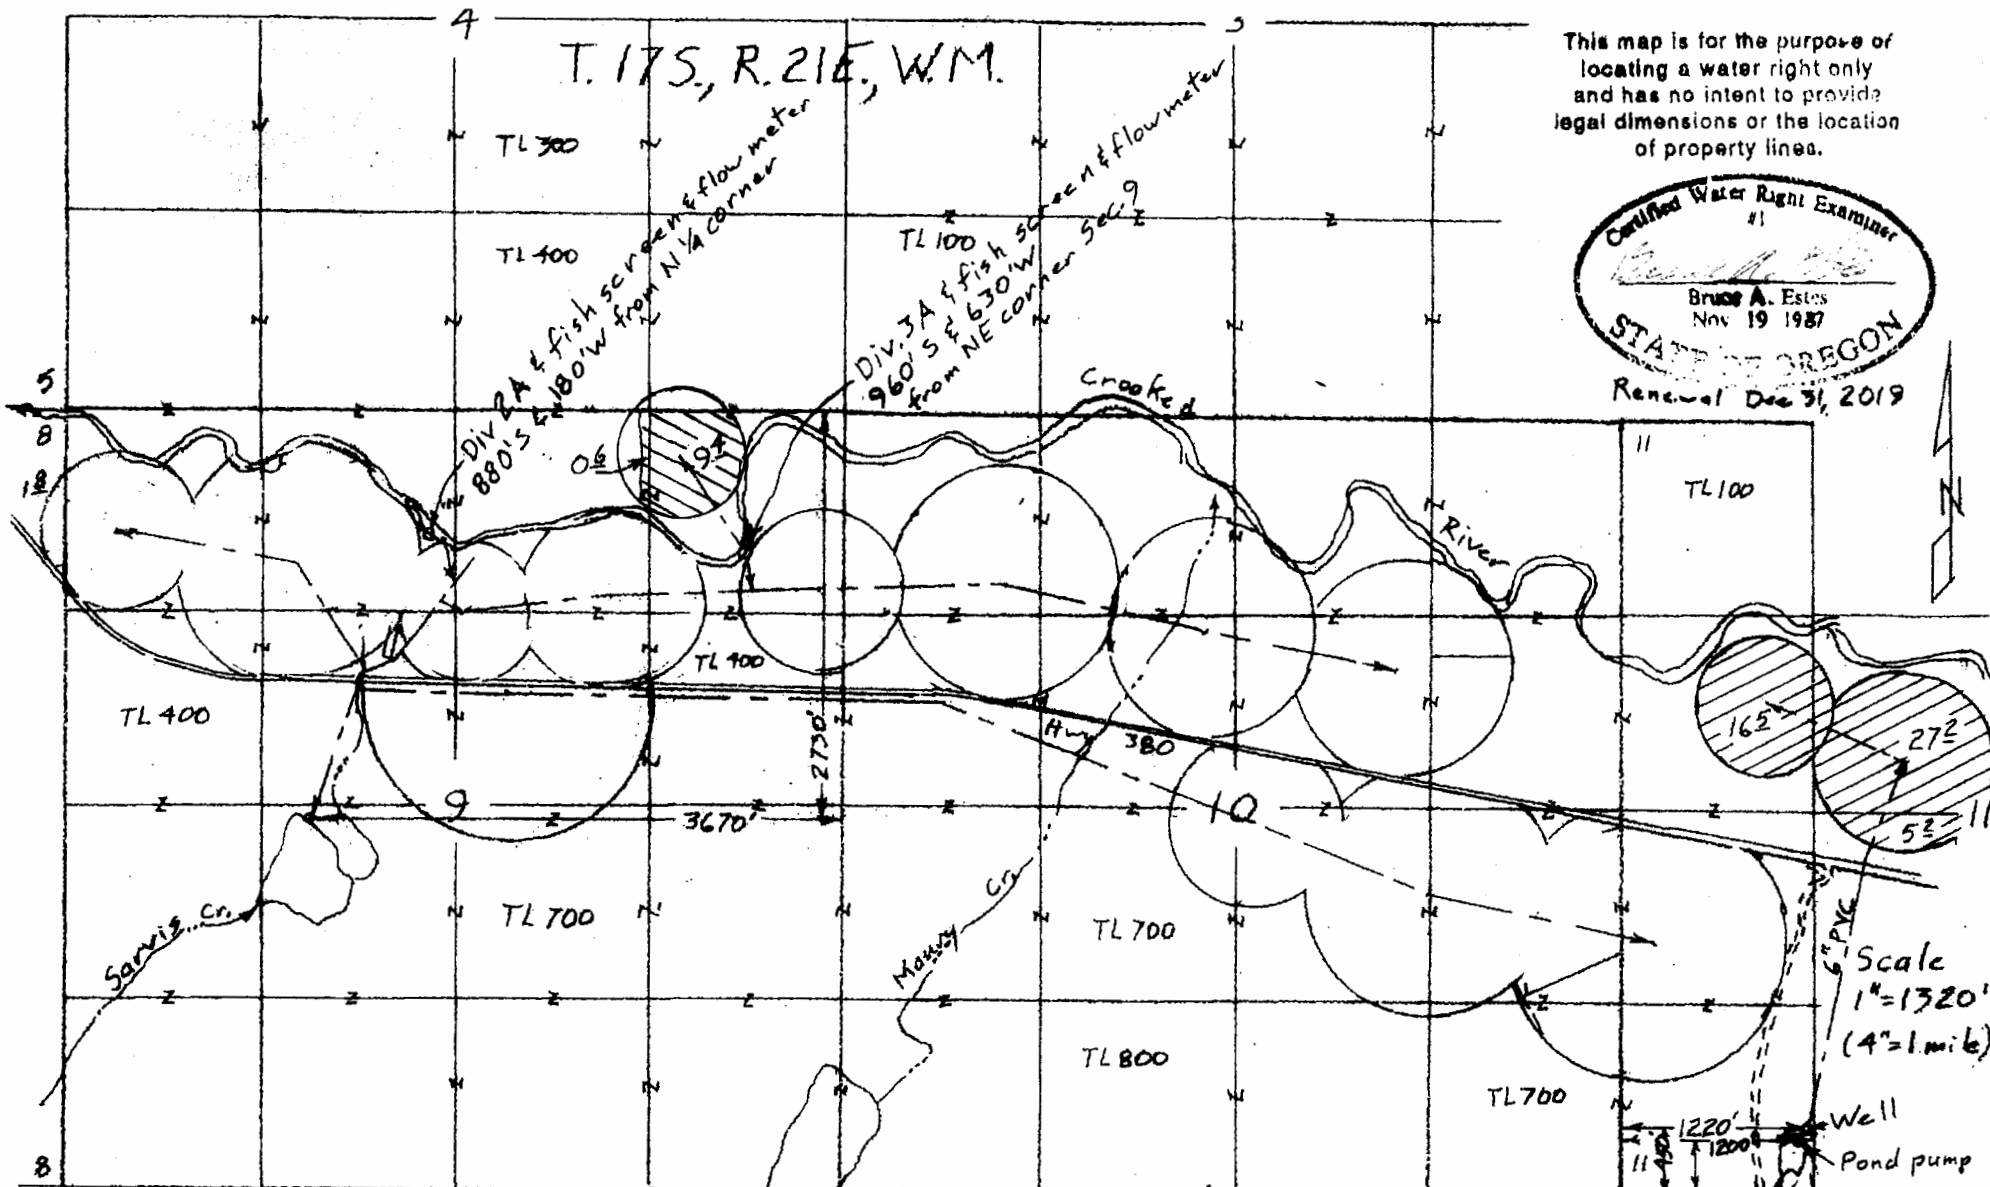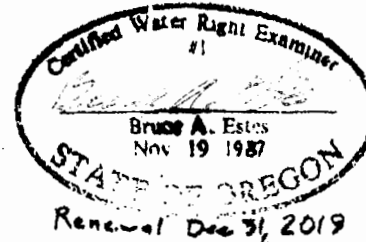

Crooked River
 C-52520 10² acres Supp (1950)
 T-12404

Surveyed Sep 2 & Oct 9 & 10, 2019
 (Cemetery Canyon)
 C-52351 482 acres (1968)
 & C-52354 482 acres Supp Well (1975)

Claim of Beneficial Use Map
 for
 Waibel Ranches, LLC

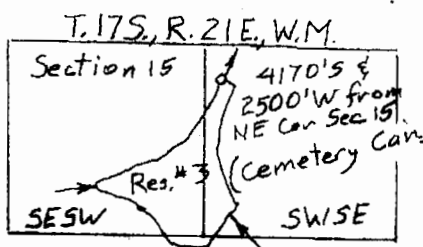

ESTES SURVEYS, LLC

PO Box 17518
 Salem, OR 97305-7518
 (503) 388-7588

80382 Arnold Rd
 Bend, OR 97702
 (541) 382-7391

Sheet 6 of 8

Scale
 1" = 1320'
 (4" = 1 mile)