
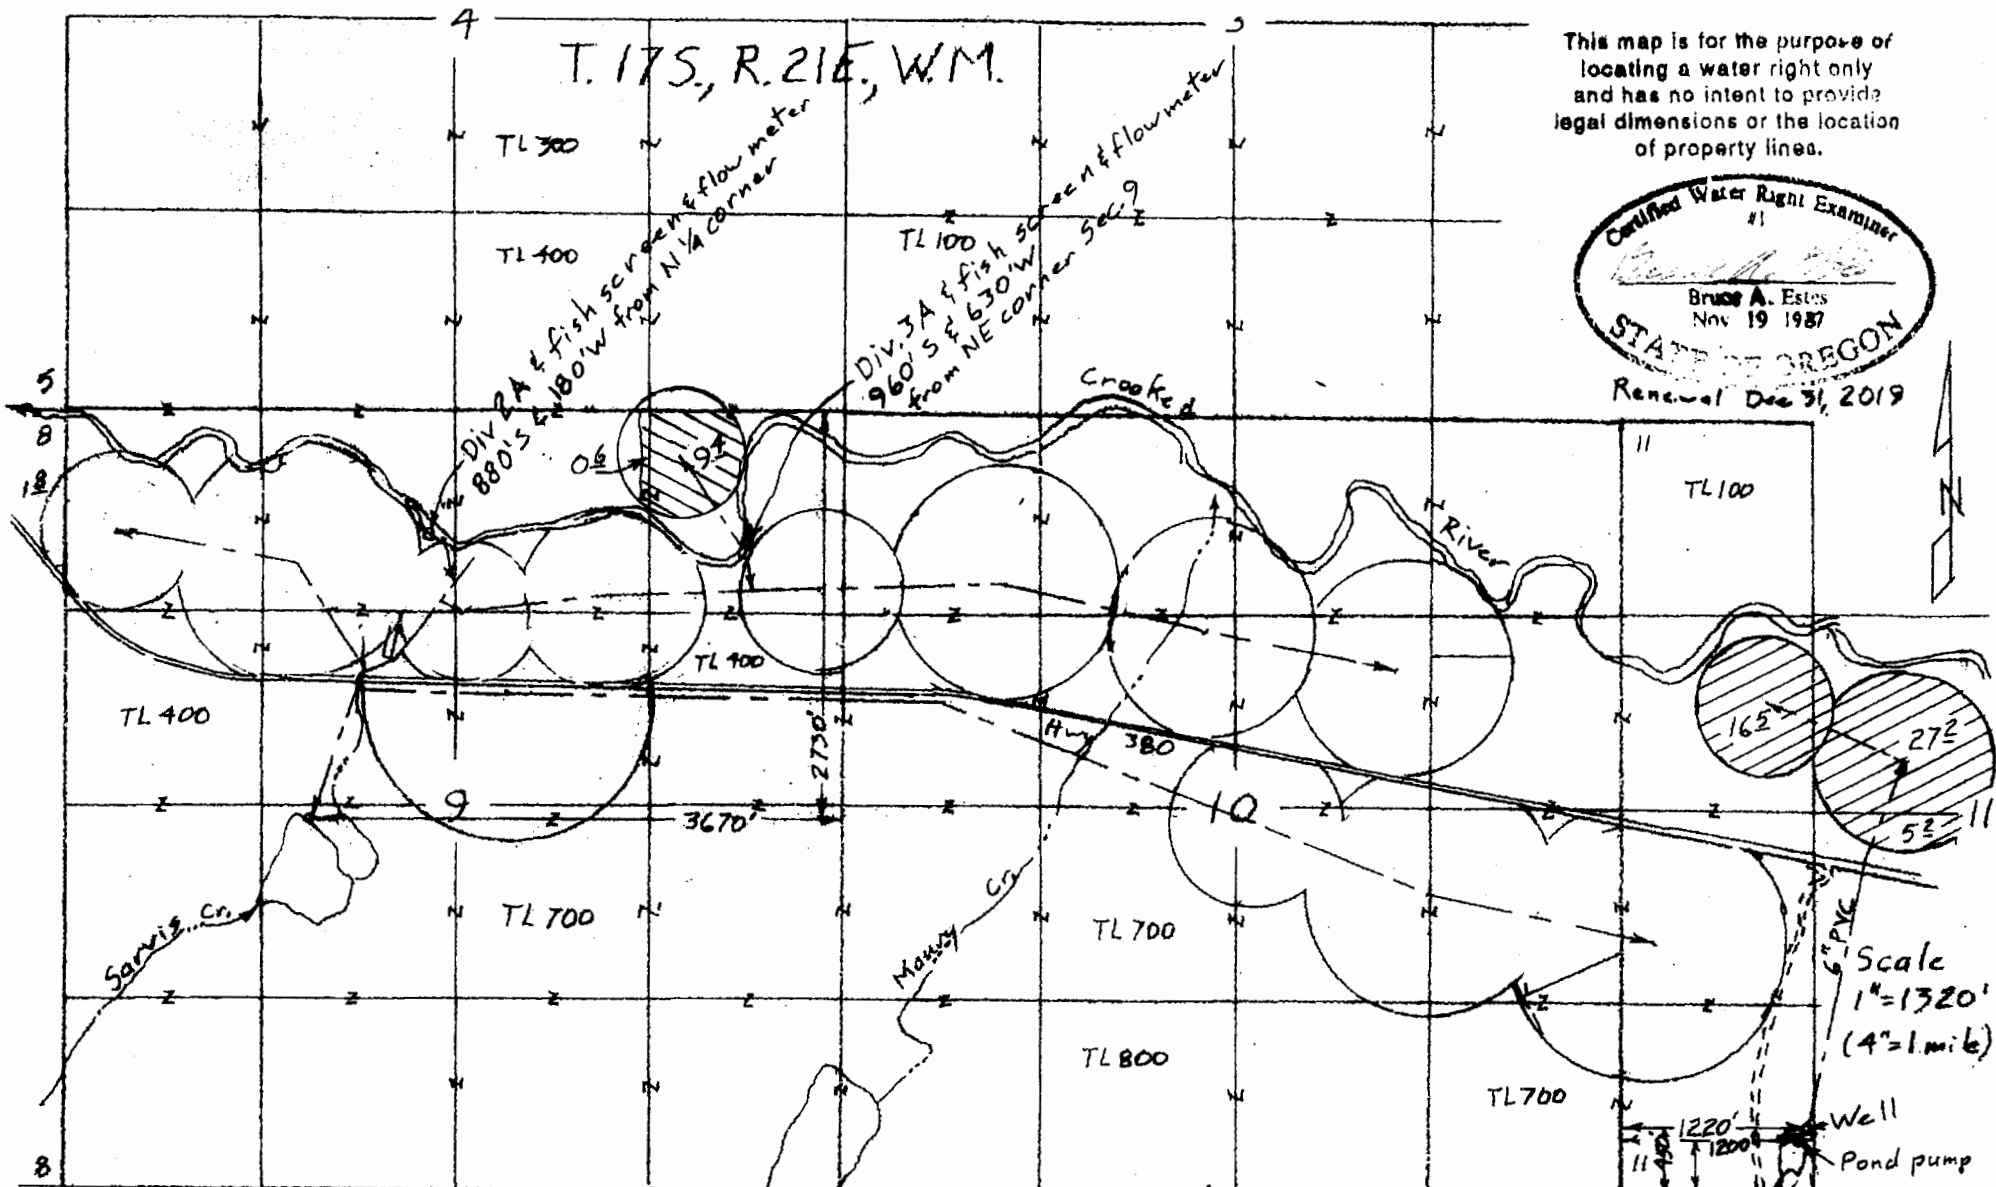


T. 17S, R. 21E, W.M.

This map is for the purpose of locating a water right only and has no intent to provide legal dimensions or the location of property lines.

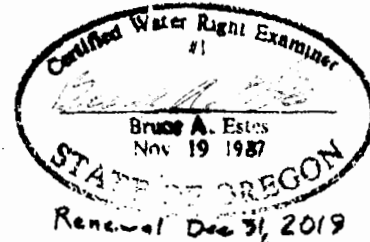


Surveyed Sep 2 & Oct 9 & 10, 2019

⊗ C-52520 10<sup>2</sup> acres Supp (1950)

T-12404

⊗ C-52351 482 acres (1968)  
 & C-52354 482 acres Supp Well (1975)

Claim of Beneficial Use Map  
 for  
 Waibel Ranches, LLC

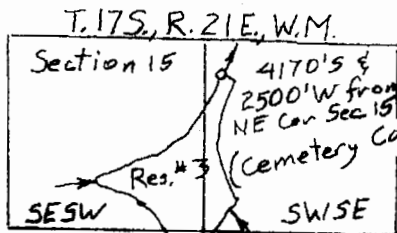

**ESTES SURVEYS, LLC**  
 PO Box 17519 Salem, OR 97305-7519 (503) 388-7500  
 80382 Arnold Rd Bend, OR 97702 (541) 382-7301

Sheet 6 of 8

Scale  
 1" = 1320'  
 (4" = 1 mile)