
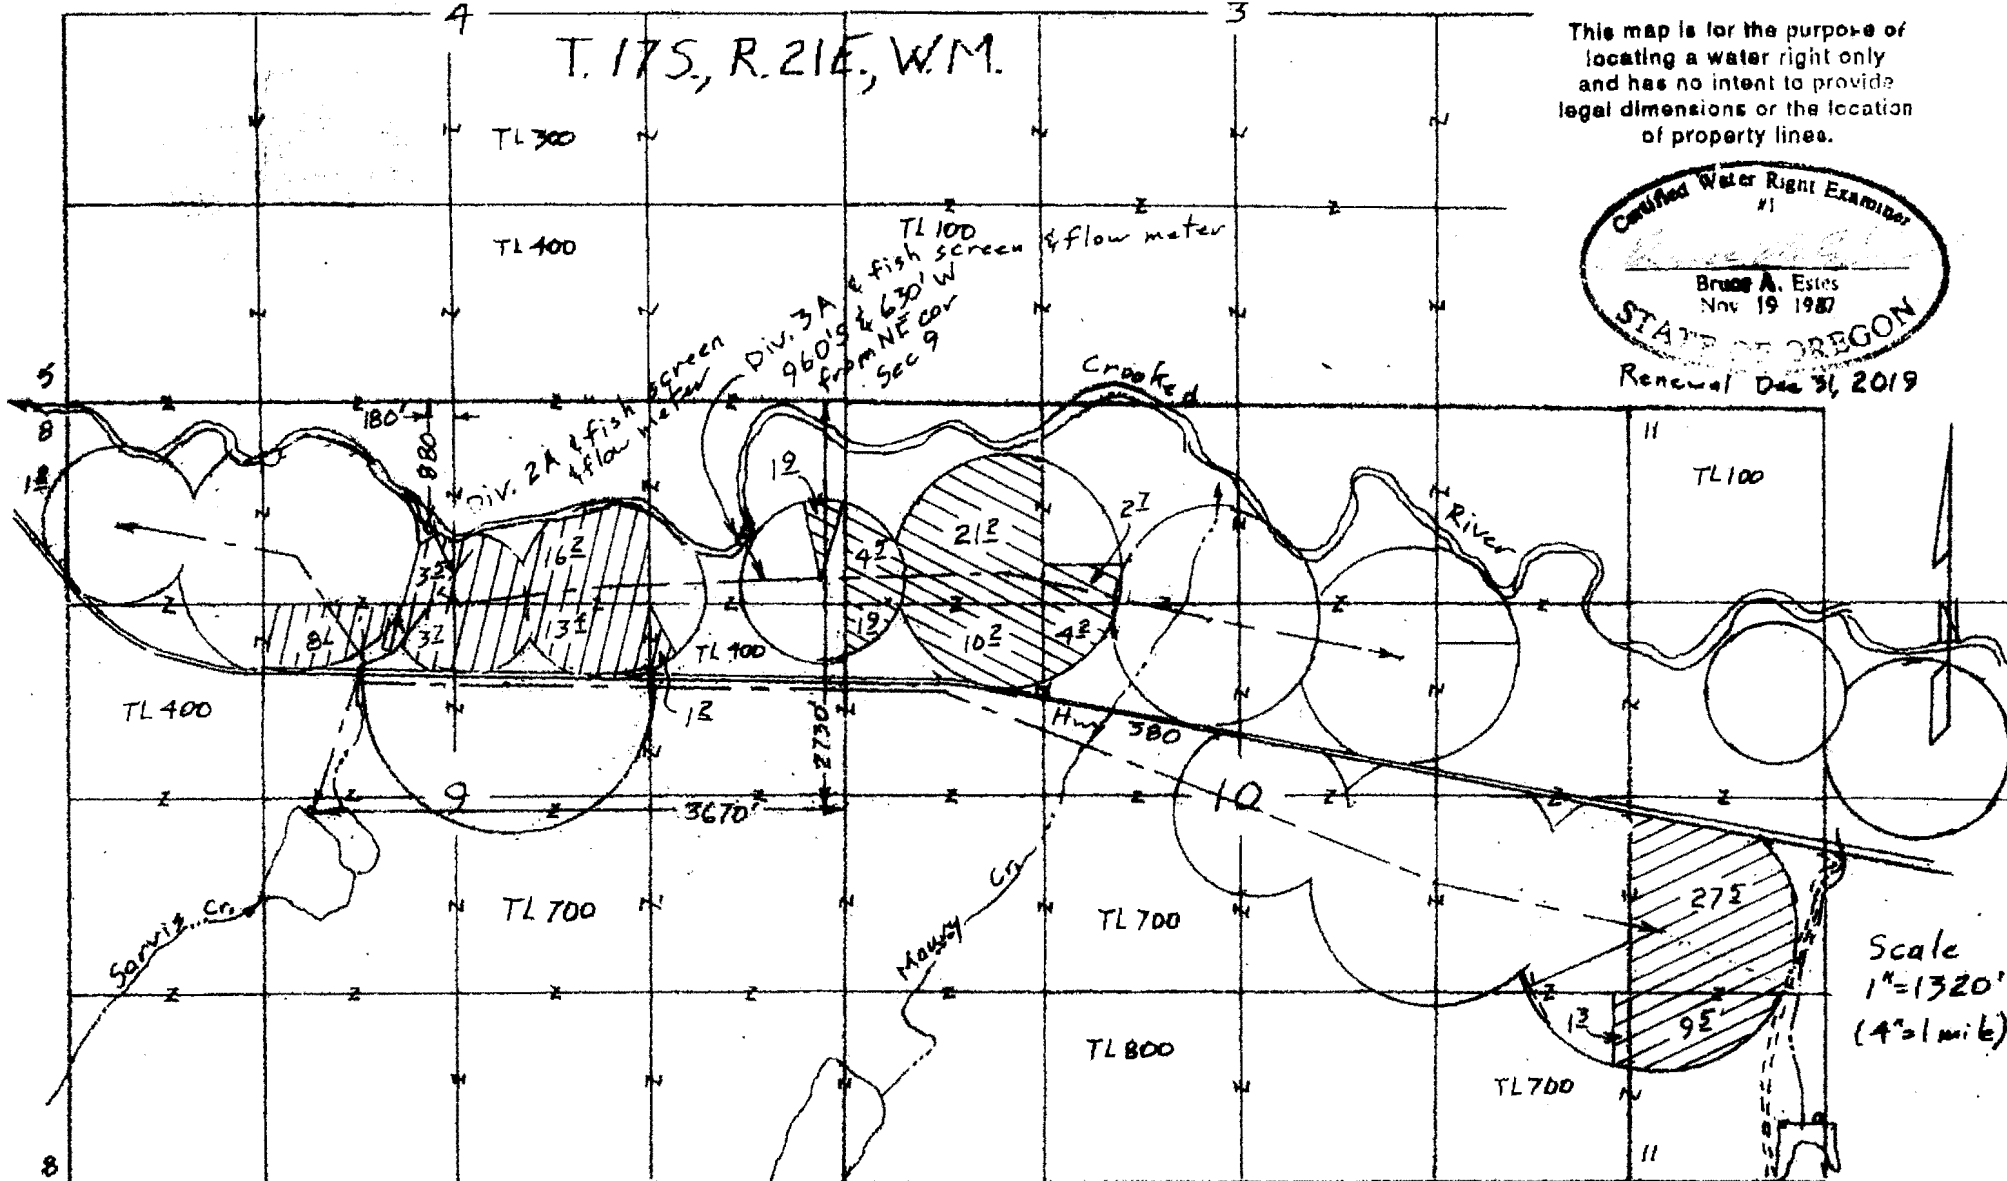


T. 17S, R. 21E, W.M.

This map is for the purpose of locating a water right only and has no intent to provide legal dimensions or the location of property lines.

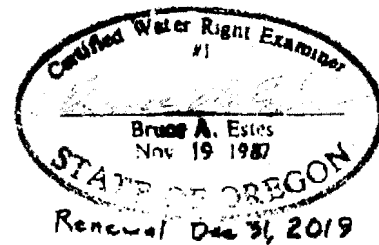

Scale
1" = 1320'
(4" = 1 mile)

- Crooked River
- ⊖ C-34225 46 1/2 acres (1956)
- ⊗ C-84305 46 1/2 acres (1960)
- ⊕ C-55659 38 3/4 acres (1970)

Surveyed Sep 2, Oct 9 10, 2019

Claim of Beneficial Use Map
for
Waibel Ranches, LLC

T-12404

Sheet 5 of 8

ESTES SURVEYS, LLC
 PO Box 17518
 Salem, OR 97305-7518
 (503) 565-7588
 60382 Arnold Rd
 Bend, OR 97702
 (541) 382-7391