

- ⊙ C-84192 115 acres (4/29/60 & 5/24/60)  
Crooked River Supplemental
- ⊙ C-89610 2± acres (6/30/55)
- ⊙ C-75947 48± acres (1893)


Scale 1" = 1320'  
(4" = 1 mile)

T-12404

Surveyed Sep 2; Oct 9 & 10, 2019

Claim of Beneficial Use Map  
for  
Waibel Ranches, LLC

This map is for the purpose of  
locating a water right only  
and has no intent to provide  
legal dimensions or the locator  
of property lines.


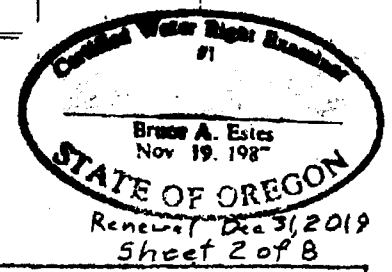


**ESTES SURVEYS**

PO Box 47518 60382 Arnold Rd  
Salem, OR 97305-7519 Bend, OR 97702  
(503) 685-7583 (541) 382-7391

T. 17S, R. 21E, W.M.

This map is for the purpose of locating a water right only and has no intent to provide legal dimensions or the location of property lines.

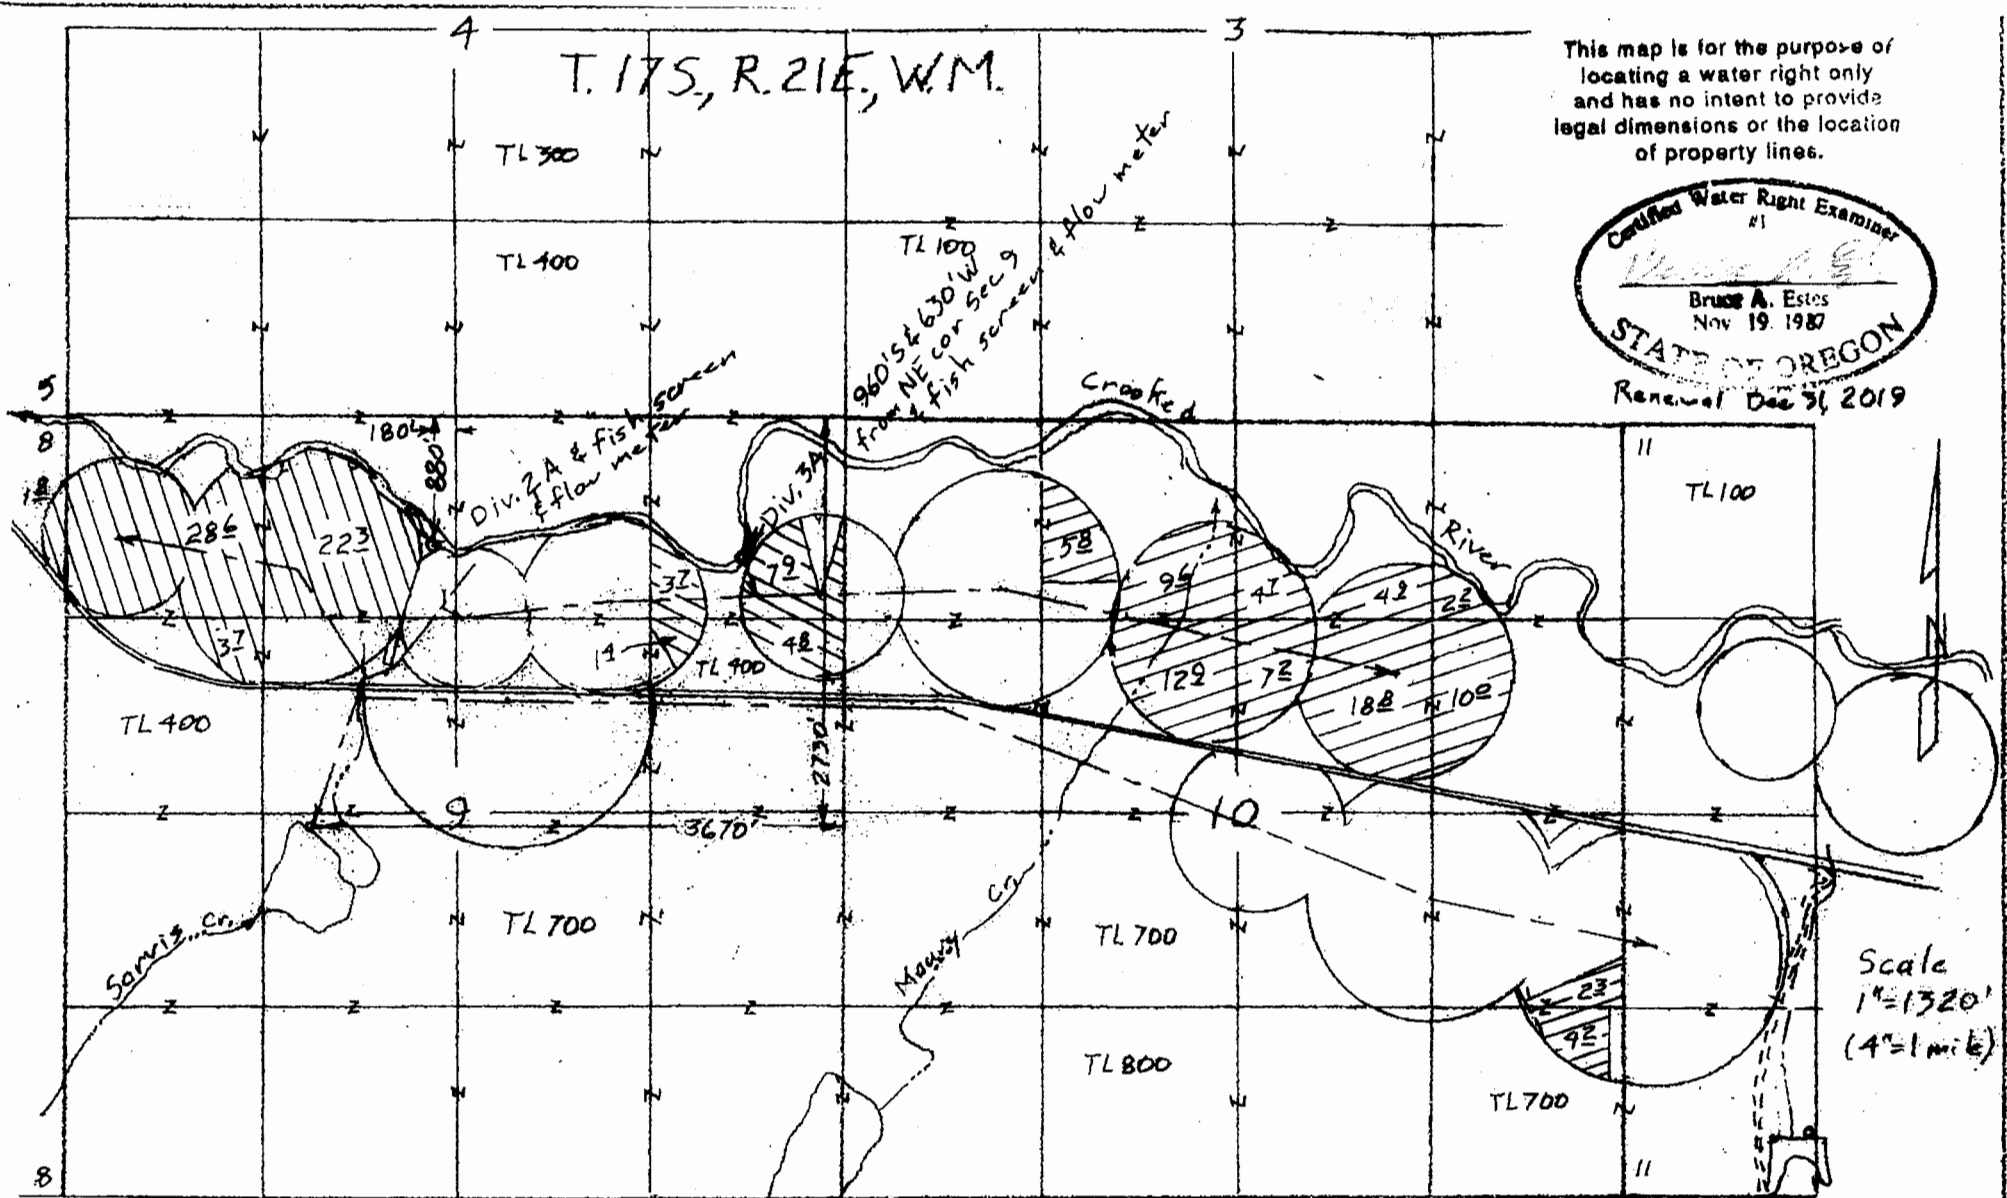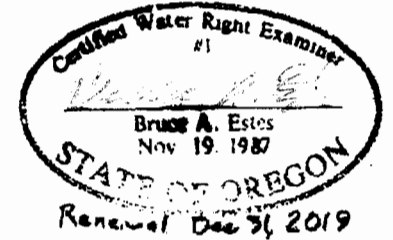

- Crooked River  
C-84192 17.8 acres (1960)
- ⊗ C-52520 56.4 acres (1950)  
Sarvis Cr. & Crooked R.

- Surveyed Sep 2; Oct 9 & 10, 2019  
Crooked River  
C-89147 82.6 acres (1959)

Claim of Beneficial Use Map  
for  
Waibel Ranches, LLC

T-12404

**ESTES SURVEYS, LLC**  
 PO Box 47518 Salem, OR 97305-7518 (503) 585-7588  
 60382 Arnold Rd Bend, OR 97702 (541) 382-7391

Sheet 4 of 8