
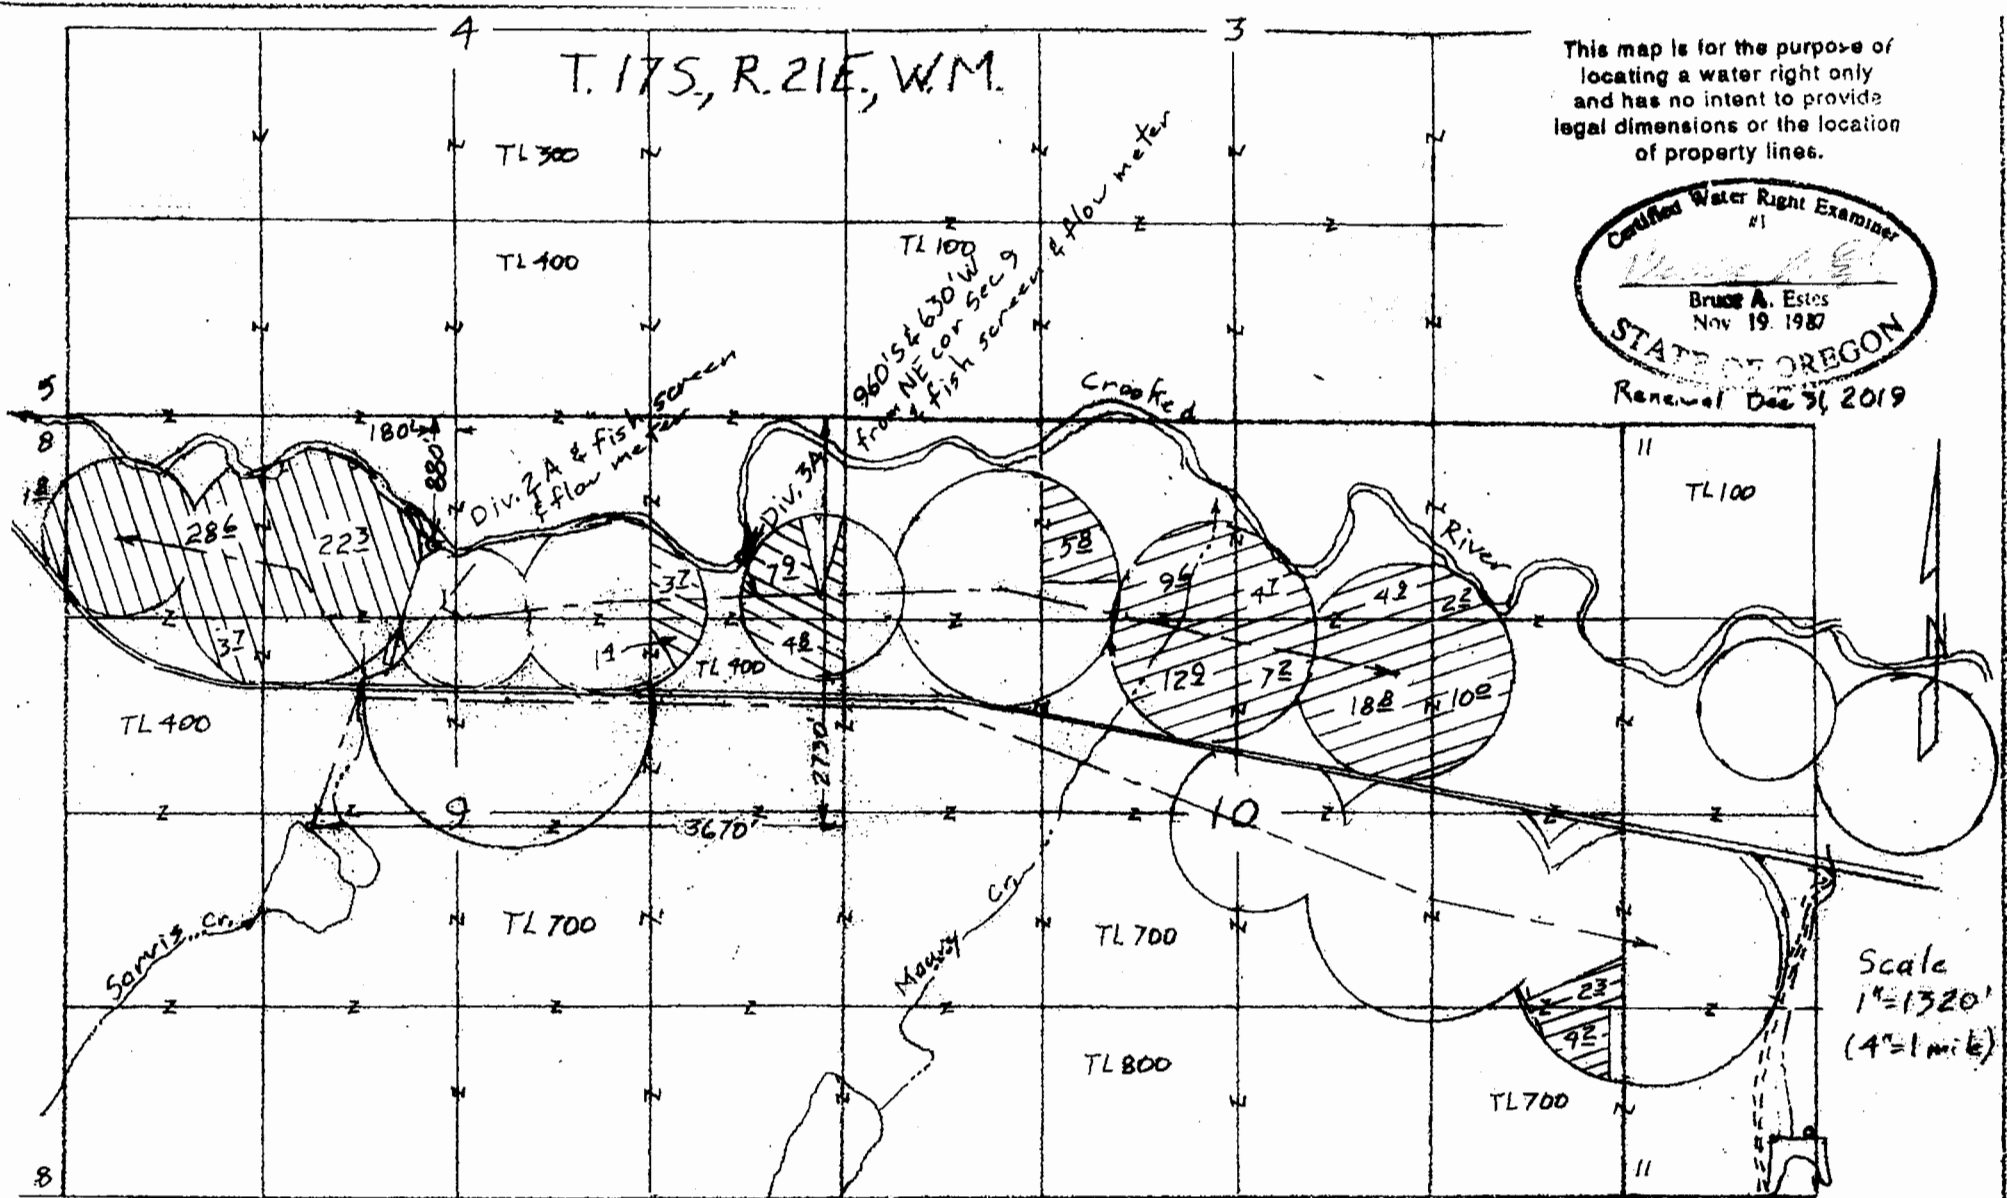


T. 17S, R. 21E, W.M.

This map is for the purpose of locating a water right only and has no intent to provide legal dimensions or the location of property lines.

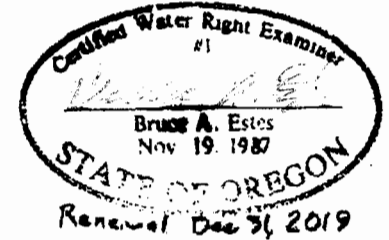

- Crooked River
C-84192 17.8 acres (1960)
- ⊗ Sarvis Cr. & Crooked R.
C-52520 56.4 acres (1950)

- Surveyed Sep 2; Oct 9 & 10, 2019
Crooked River
C-89147 82.6 acres (1959)

Claim of Beneficial Use Map
for
Waibel Ranches, LLC

T-12404

ESTES SURVEYS, LLC
 PO Box 47518 Salem, OR 97305-7518 (503) 585-7588
 60382 Arnold Rd Bend, OR 97702 (541) 382-7391

Sheet 4 of 8