
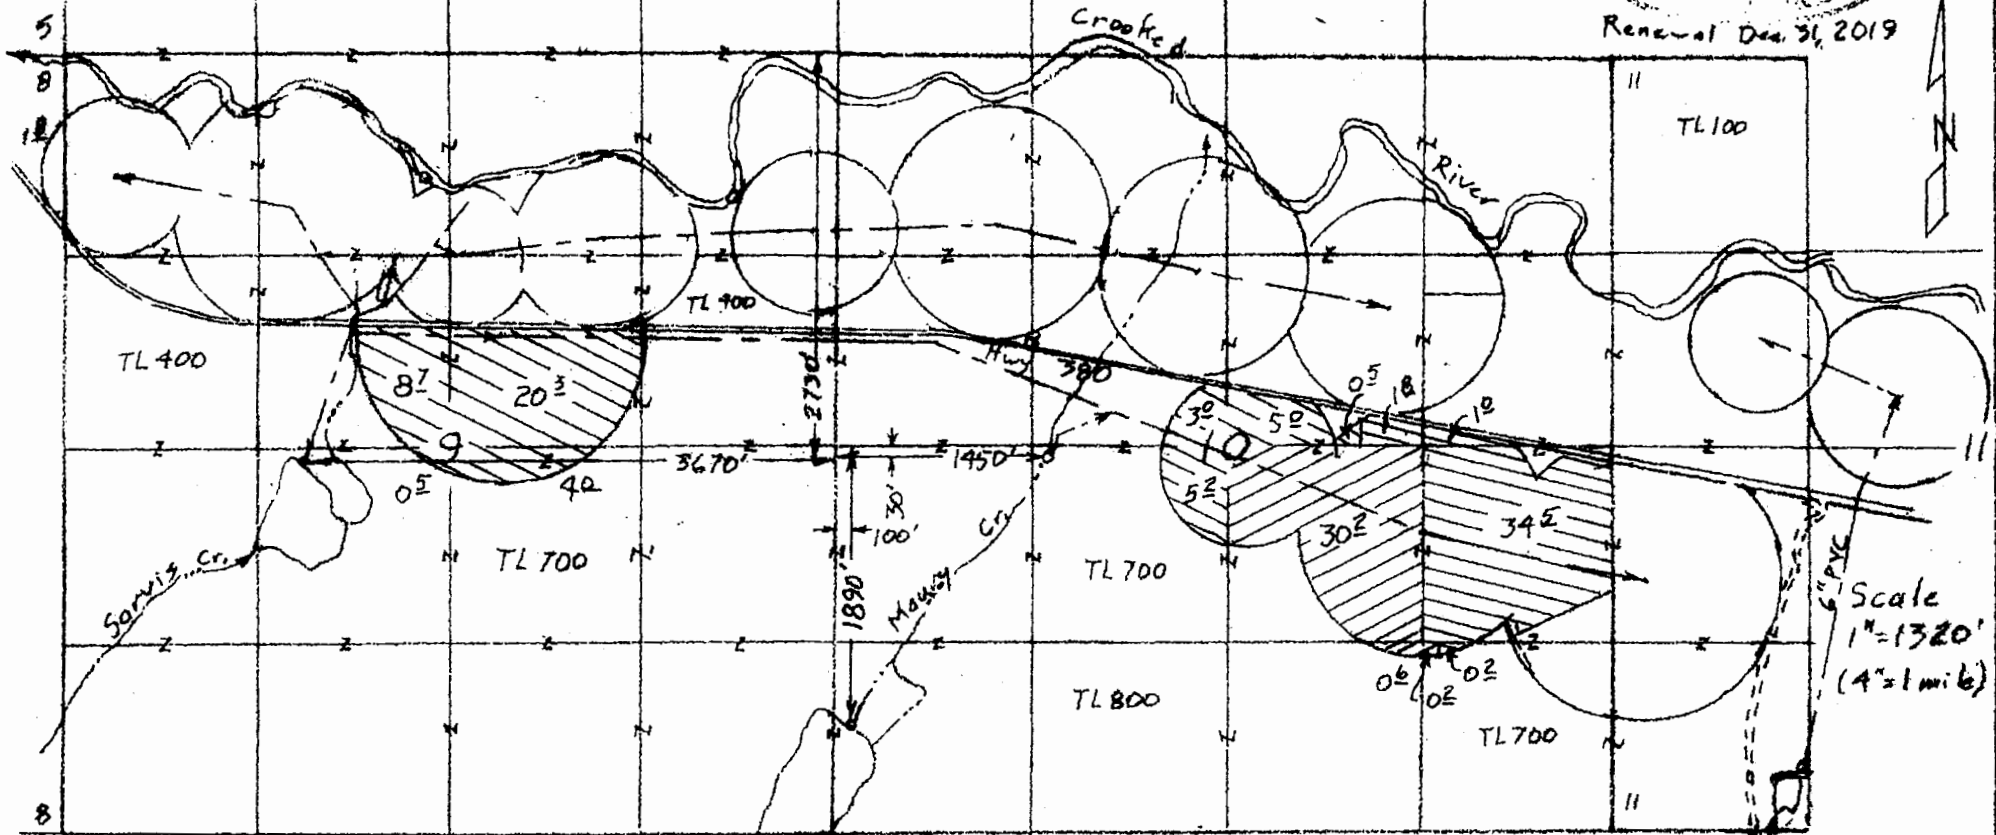


T. 17S, R. 21E, W.M.

This map is for the purpose of locating a water right only and has no intent to provide legal dimensions or the location of property lines.

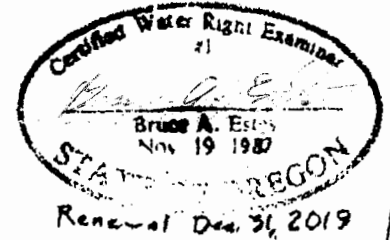

Scale  
1"=1320'  
(4"=1 mile)

Sarvis Cr. & Res.

⊗ C-37548 473 acres (1966)

Surveyed Sep 2, Oct 9 & 10, 2019

Maury Cr.

⊗ C-89146 312 acres (1885)  
& C-89148 312 acres (1966)  
Maury Cr. & Res.

Maury Cr. & Res.

⊗ C-89148 375 acres (1966)

Claim of Beneficial Use Map  
for  
Waipol Ranches, LLC

T-12404

Sheet 7 of 8

**ESTES SURVEYS, LLC**

PO Box 17518  
Batem, OR 97005-7518  
(503) 385-7500

60382 Arnold Rd  
Batem, OR 97702  
(541) 382-7381