
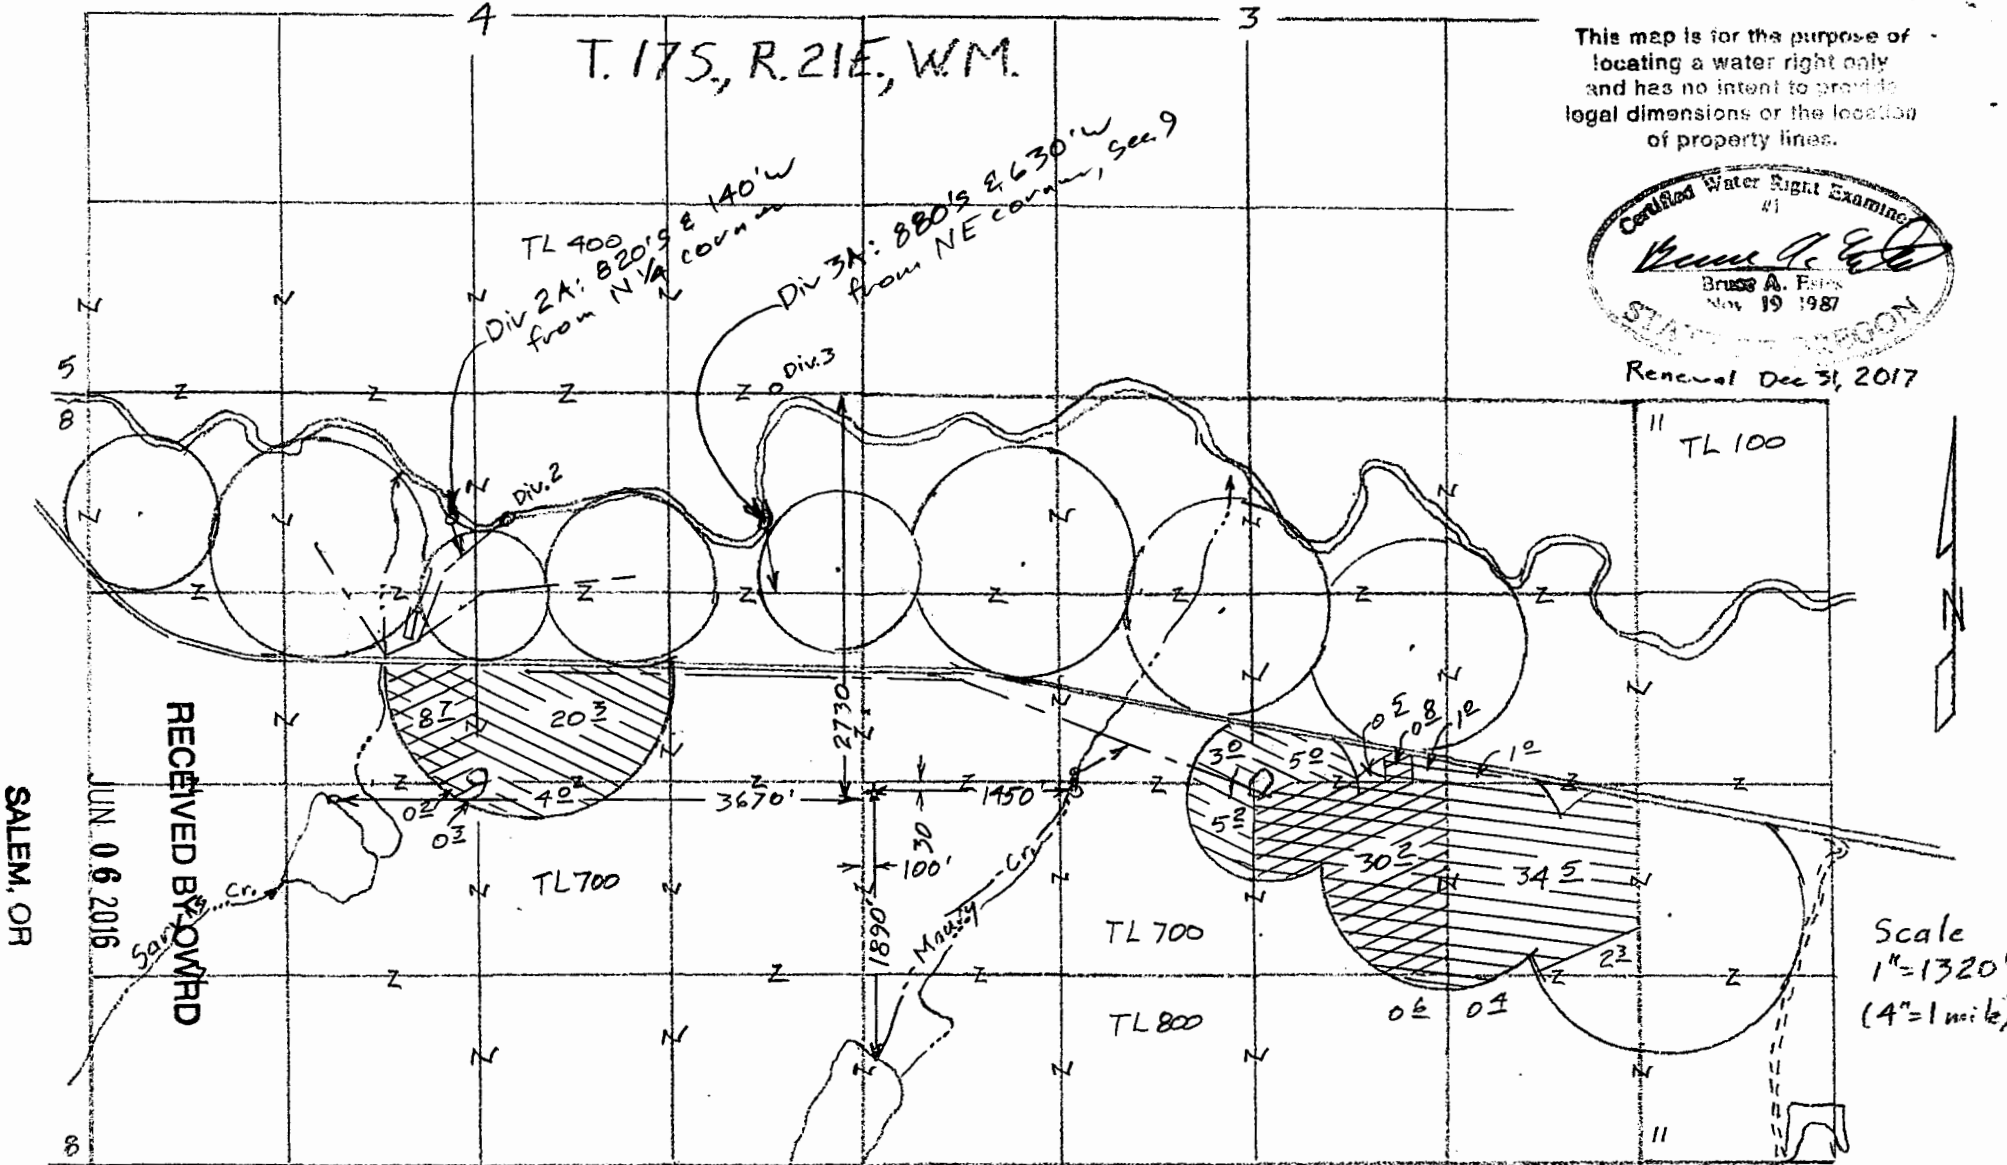


T. 17S., R. 21E., W.M.

This map is for the purpose of locating a water right only and has no intent to provide legal dimensions or the location of property lines.

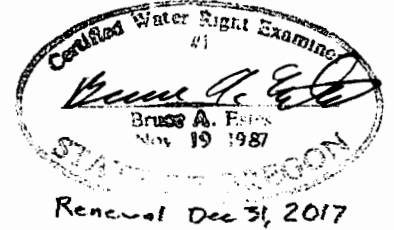

To: Sarvis Cr. & Res.
 C-37548 47 $\frac{1}{2}$ acres
 6/21/1966
 C-55659 82 acres (C.R. 7/15/70)
 Supp

To: Maury Cr.
 C-89146 31 $\frac{1}{2}$ acres
 1885

To: Maury Cr & Res.
 C-89148 68 $\frac{1}{2}$ acres
 9/26/1966

12404

Transfer Application Map
 for
 Waibel Ranches, LLC

ESTES SURVEYS, LLC
 PO Box 17510 30382 Arnold Rd
 Salem, OR 97305-7510 Bend, OR 97702
 (503) 585-7500 (541) 382-7391