





Claim of Beneficial Use
Permit G-17843 Application G-17255
In the name of Connie Hines

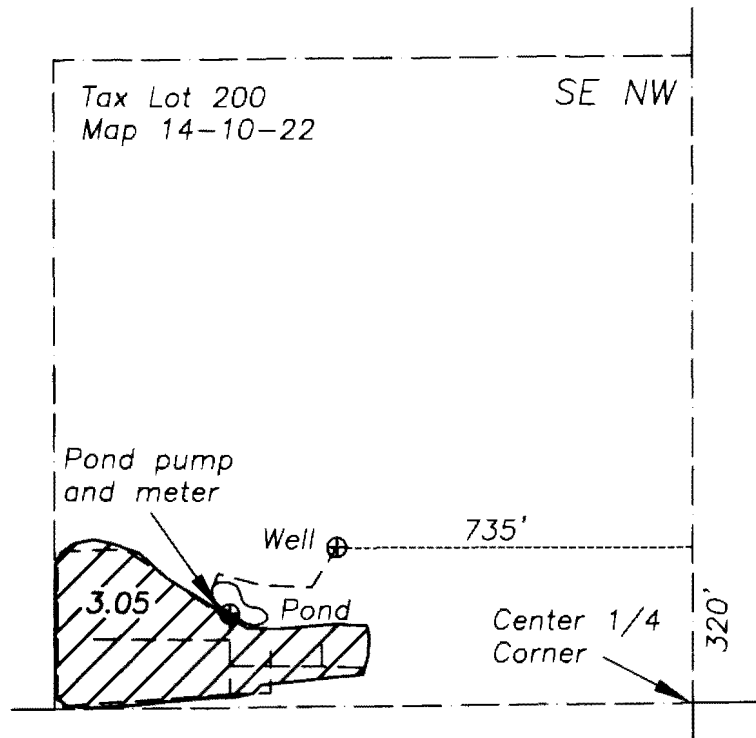

Section 22
T14S R10E WM
Deschutes Co. Oregon

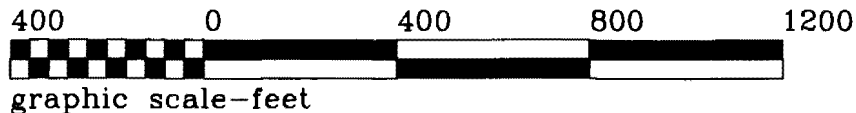

This map is for the purpose of identifying the location of the water right. It is not intended to provide legal dimensions or locations of property ownership lines.

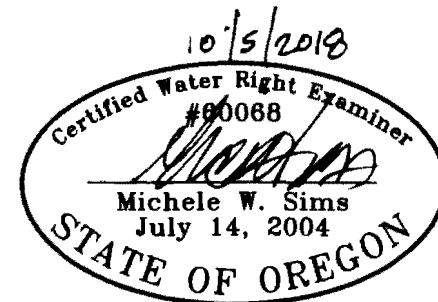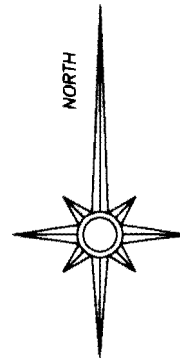


Renewal date: 6/30/2020

Point of Appropriation


320' North and 735' West from the Center 1/4 of Section 22



Beneficial use under Permit G-17843
(Priority date 8/21/2009)

 

Tax lot boundary

 

Buried mainline



Well and meter



1/16 Section lines