


**Claim of Beneficial Use Map
T-8916
Patricia Wintemute**

T36S, R1E, Sec 3

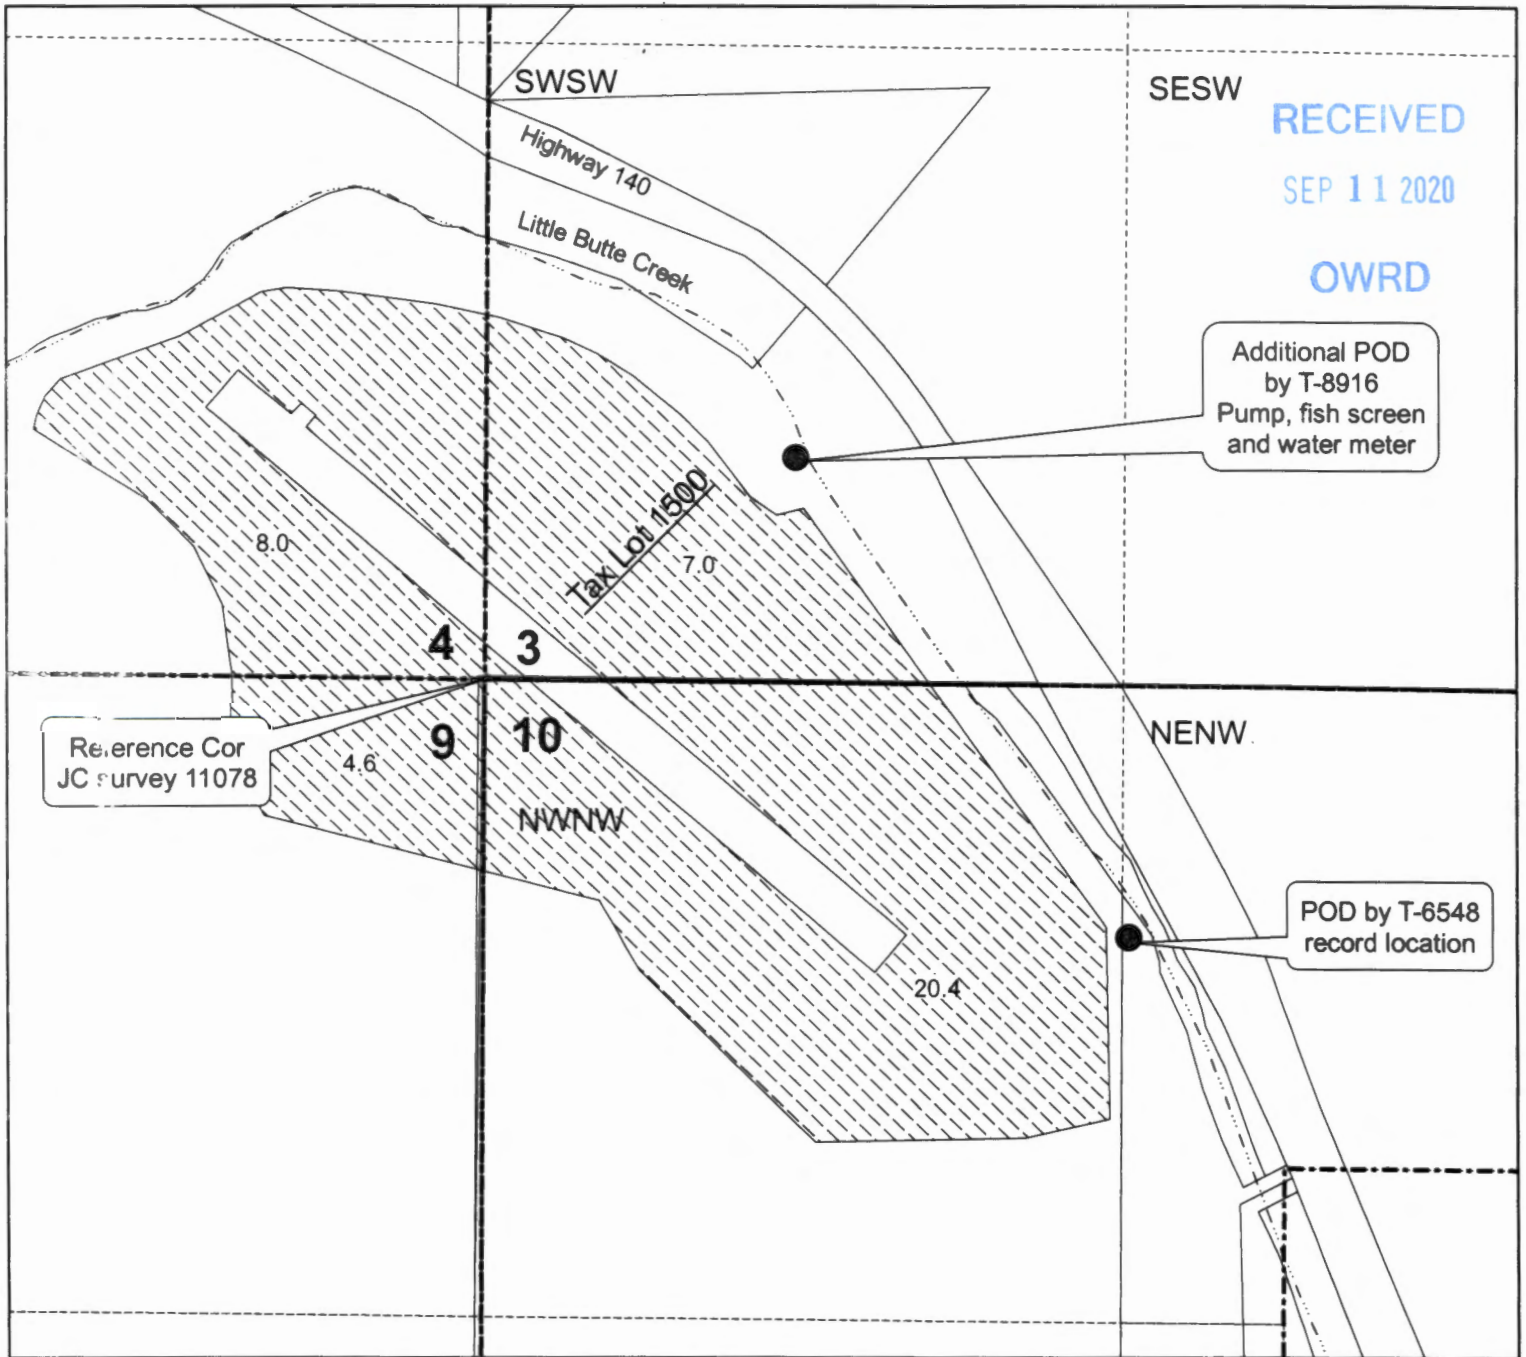

RECEIVED

SEP 11 2020

OWRD

Additional POD
by T-8916
Pump, fish screen
and water meter

Reference Cor
JC survey 11078

POD by T-6548
record location

The additional Point of Diversion is located 450 feet North & 650 feet East from the SW Corner of Section 3, T 36 S, R 1 E.


The existing Point of Diversion location of record is 470 feet South and 1320 feet East from the NW Corner of Section 10.

Legend

- T-8916 POD
- Little Butte Creek
- ▨ Record Place of use No Change



1 inch = 400 feet

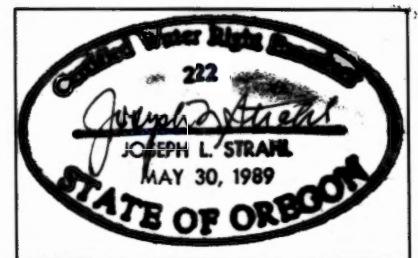

Note: This map is not intended to provide legal dimensions or locations of property ownership lines.