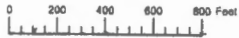



$$1'' = 800'$$


198 acres in
SECTION 12 T.1N. R.40E. W.M.
UNION COUNTY

 $1^{\text{st}} = 400$

01N40E12

Cancelled
301
500

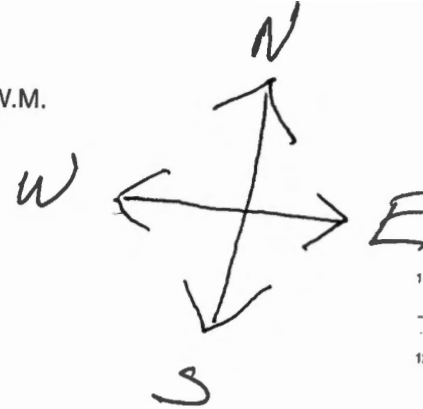

Application #
R 88094

Permit #
R 15145

Center of Pond


Latitude
45.585281

Longitude
117,763 437


RECEIVED

JUN 12 2018

OWRD

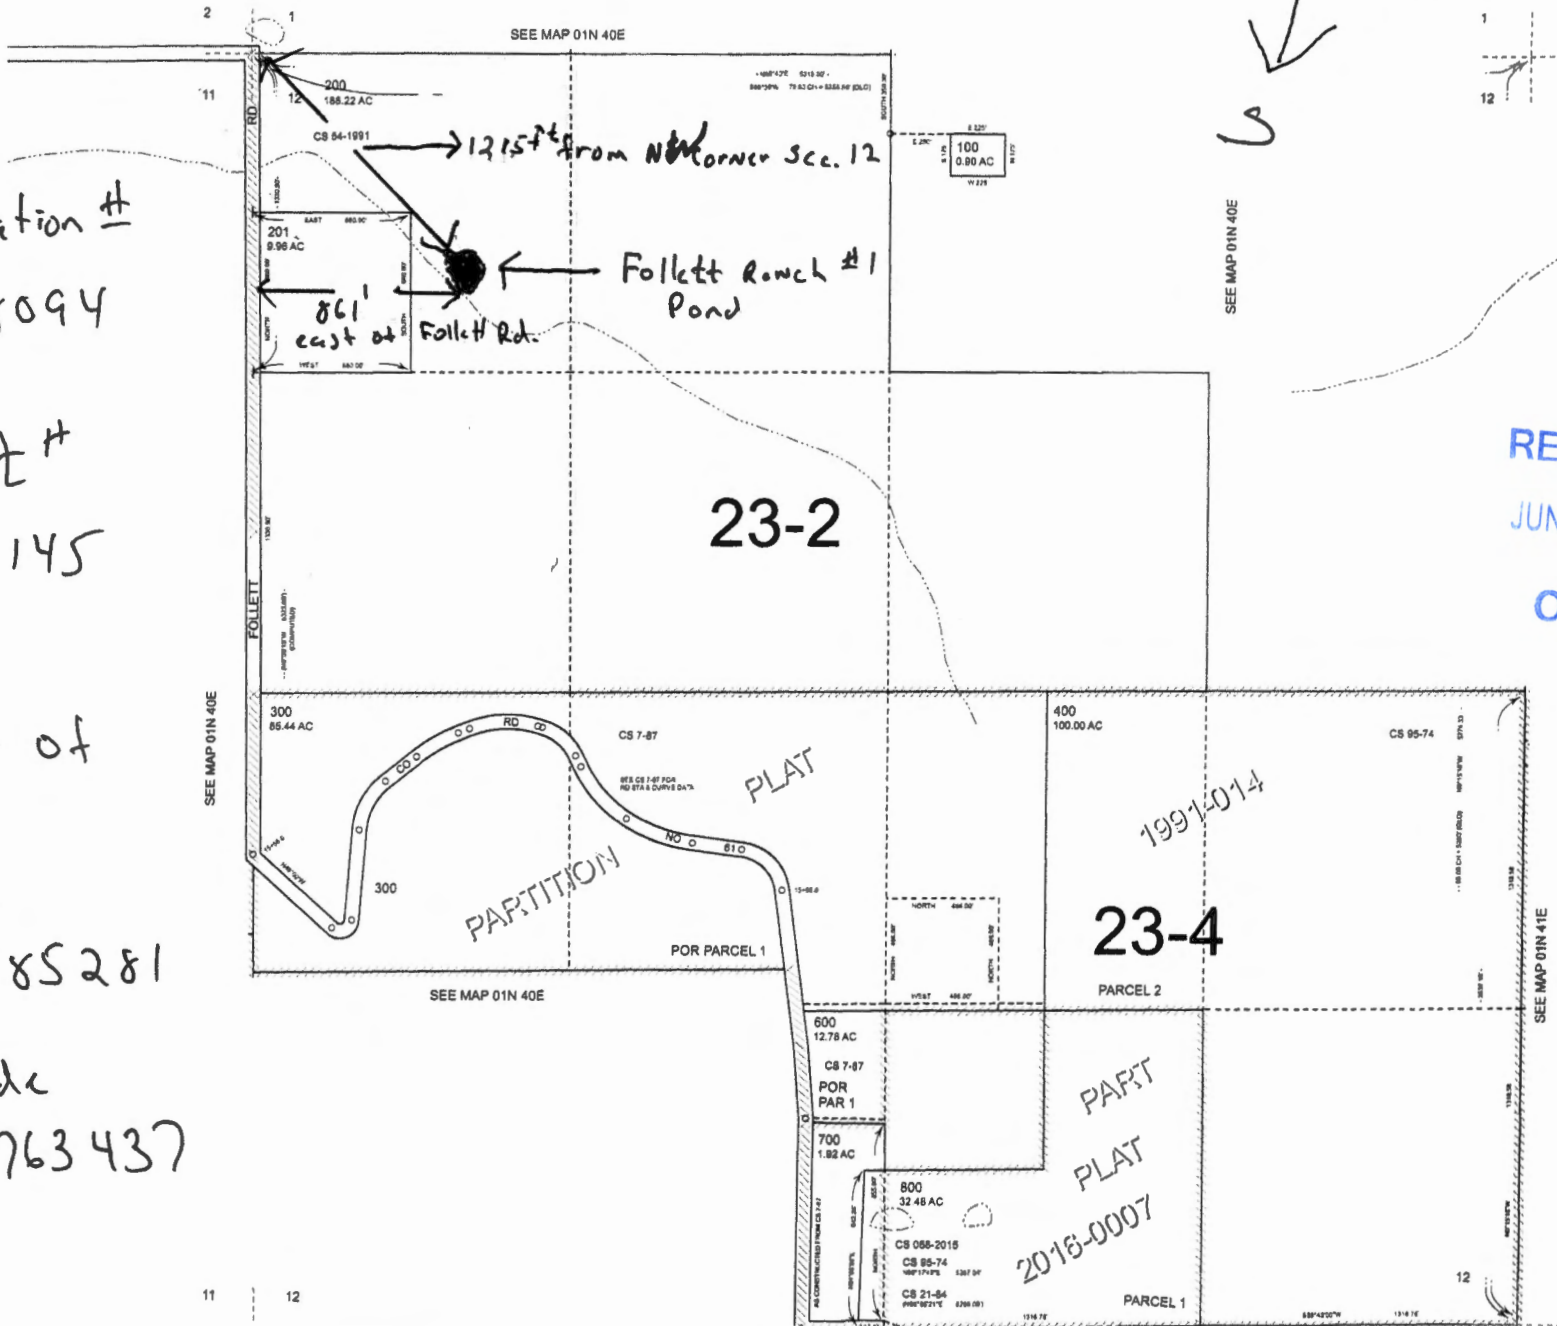

Boyd Follett
P.O. Box 810
Elgin, OR
97827

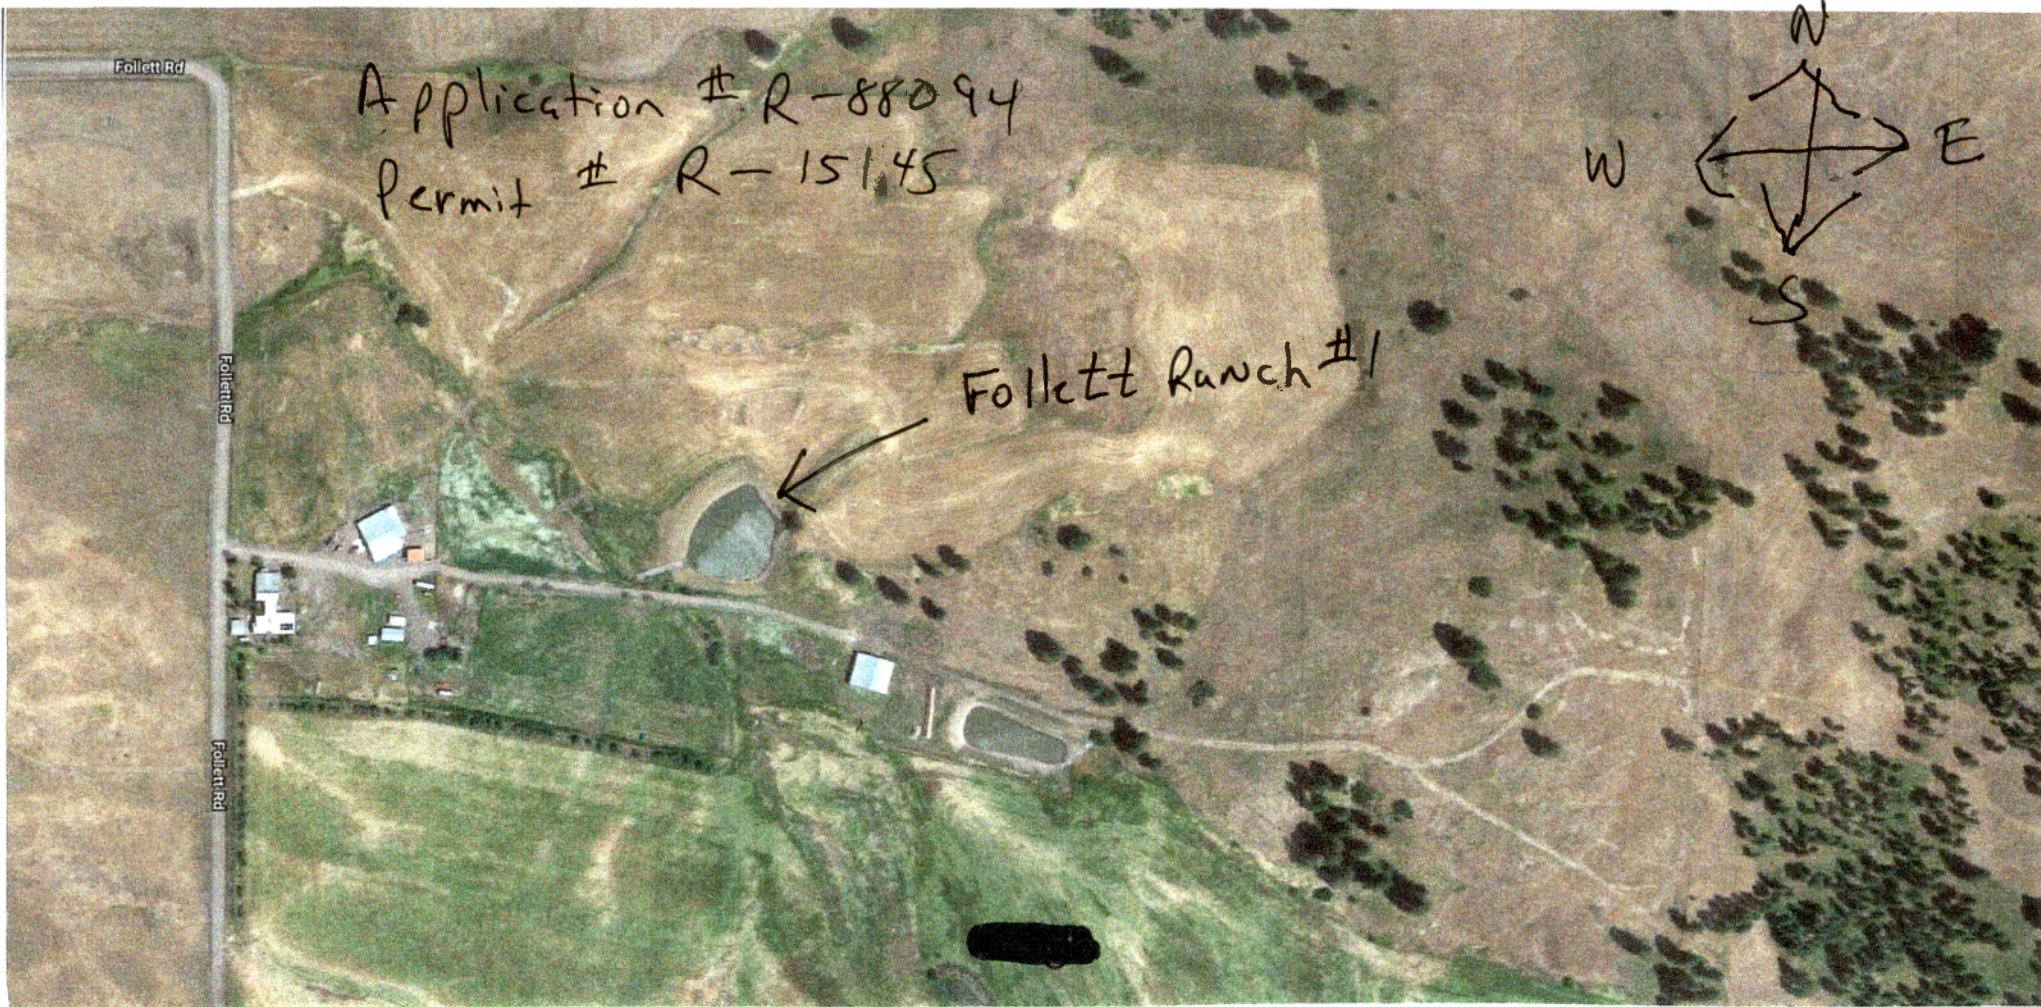

Middle of pond Latitude 45.585281 + Longitude 117.763437
1215' from ~~NEW~~ Corner Section 12, Township 1N, Range 40E Willamette Meridian
861' East of Follett Road which is western section line for Section 12
732' South of Northern section line for Section 17
Tax lot 200 in Union, County, OREGON - 198 acres

RECEIVED

JUN 12 2018

OWRD